

Attala
K2089
1-68

MISSISSIPPI
BOARD OF WATER COMMISSIONERS
416 North State Street
Jackson, Mississippi 39201

WATER WELL DRILLERS LOG

1-30 1968 Thomas & Son Attala
date well completed firm name county well located


LANDOWNER: Mrs. Addington
Hwy 12 East
Durant, Miss.
(mailing address)

WELL LOCATION:
sec 20 T 14 N R 5 E
S W
3 miles E of Durant
(distance) (direction) (nearest town)

WELL PURPOSE:
(home irrigation, municipal, industrial)

- WELL COMPLETION DATA:
- (1) diameter (inches) 2
 - (2) total depth (feet) 63
 - (3) static water level (feet) 40 below top of ground.
 - (4) casing Galv. 58
(material) (depth)
2" if telescope see back.
(size)
 - (5) screen 5 58
(length) (depth to top)
8 ft 1/4" stainless
(size) (material)
 - (6) pump Hand Pump
(HP) (yield gpm)
 - (type power)
 - (7) electric log no
(yes or no)
 - (organization running log)
 - (8) how well bottom plugged

description of formations encountered	from	to
Red clay	0	10
Chalk	10	42
Sand w/ chalk	42	52
Coarse Red Sand	52	63
Black Dirt	65	83
Sandrock	83	86
At 86 ft. we hit some sort of rock that we failed to scratch out. Two roller bits down smooth in 30 minutes. Never seen anything that hard.		

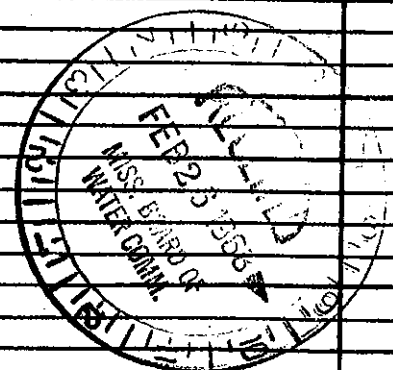

DRILLERS REMARKS: