

ATTALA MISSISSIPPI BOARD OF WATER COMMISSIONERS

WATER WELL DRILLERS LOG

1-17-61

Date: 1-17, 1961, Driller: Smith & Presley County, Attala

(1) Owner of Land: V.F.W HOME
 (Name)
Kosciusko Miss
 (Address)

(2) Location: SW 1/4 NW 1/4, Sec. 36 T14 R63
 (distance) (direction) (Nearest Town)
2 1/2 miles W NW 1/4 of Kosciusko

(3) Topography: Hilly
 (Hilly) (Flat) (Level)

(4) Purpose of Well: Domestic
 (Domestic Irrigation, Municipal, Industrial, Other)

Description & Color of Materials Sand, Clay, Red Clay, Shell, etc.	Thick- ness Feet	Depth Feet
Reddish sand	20	20
1 1 11	20	42
White sand	20	63
1 1 11	20	84
Clay	10	94
White sand	11	105
Sand clay mixture	21	126
1 1 11	10	137
1 1 11	11	147
blue clay	10	157
3 or 4 thin Rock	0	157
black clay	8	165
Silt	3	168
gray Rock	12"	178
gray Rock and shale		
black silt	4	183
little sand with		
a black mixture	5	198
sand little coarser		
with black mixture	12	210
gray Rock		
sand with		
black mixture	12	222
Rock	4	226
black sand	3	229
coarse white sand	3	232
greenish white med.		
sand	15	247
coarse green sand		
shell mixture	5	252
sand and clay and shale		

Information upon completion of well:

(1) Diameter 3 inches.

(2) Total Depth 303 feet.

(3) Water Level 100 feet below top of ground.

(4) Cased to 147, Size 3" X 2"


(5) Screen: Size 2", Length 12'

(6) Were any formations sealed against pollution?
 yes, 1 no

If YES depth of formation

Why

Drillers Remarks:

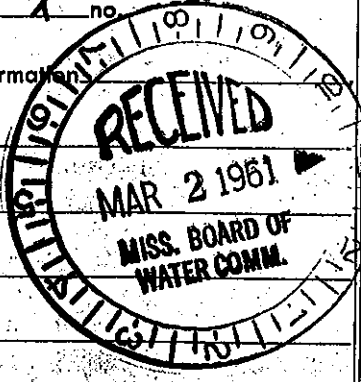

(Use Back Side)

! this copy to Board of Water Commissioners 429 Miss. St. Jackson, Miss

Well No. 12