


L **ATTALA** **WATER WELL DRILLERS LOG**

3-6-62, 1962, Driller: Thomas & Son Drilling Co. County Attala **L 23**
 (Name)

	Description & Color of Materials Sand, Clay, Red Clay, Shell, etc.	Thick- ness Feet	Depth Feet
(1) Owner of Land: <u>Vera A. Toler</u> (Name) <u>Hwy 12 Kosciusko, Miss.</u> (Address)	<u>SAND</u>	<u>40</u>	<u>0-40</u>
(2) Location: <u>SW 1/4, SE 1/4, Sec 25 T14R6,</u> <u>3</u> miles <u>West</u> of <u>Kosciusko,</u> (distance) (direction) (Nearest Town)	<u>Chalk or clay</u>	<u>40</u>	<u>80</u>
(3) Topography: <u>Hilly</u> (Hilly) (Level)	<u>SAND</u>	<u>11</u>	<u>91</u>
(4) Purpose of Well: <u>Domestic</u> (Domestic Irrigation Municipal, Industrial, Other)	<u>Replaced L 3</u>		
Information upon completion of well:			
(1) Diameter <u>2</u> inches.			
(2) Total Depth <u>91</u> feet.			
(3) Water Level <u>60</u> feet below top of ground.			
(4) Cased to <u>85</u> , Size <u>2</u> .			
(5) Screen: Size <u>60</u> , Length <u>6 Ft.</u>			
(6) Were any formations sealed against pollution?			
_____ yes, <u>X</u> no.			
If YES depth of formation _____			
Why _____			
Drillers Remarks: _____			

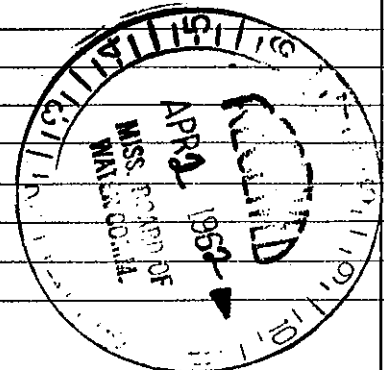

(Use Back Side)

Well No.

Mail this copy to Board of Water Commissioners 429 Miss. St. Jackson, Miss