

L 24  
12-11-61

Code

L-24

WATER WELL DRILLERS LOG

Date: 12-11, 1961, Driller: Smith & Presley County Attala  
(Name)

		Description & Color of Materials Sand, Clay, Red Clay, Shell, etc.	Thick- ness Feet	Depth Feet
(1) Owner of Land: <u>J. B. Drumake</u> (Name)		yellow <del>clay</del> sand	29	29
<u>R. B. Kosciuszko</u> (Address)		yellow clay	11	40
(2) Location: SW 1/4, W 1/2, Sec. 36 T14R6		blue clay	49	89
<u>3 1/2</u> miles <u>W</u> of <u>Kosciuszko</u> (distance) (direction) (Nearest Town)		blue black clay	9	99
(3) Topography: <u>Hilly</u> (Hilly) (Flat) (Level)		hard pan about	2"	
(4) Purpose of Well: <u>Domestic</u> (Domestic Irrigation Municipal, Industrial, Other)		blue black rock	4"	94
		blue gray rock	3'	97
		blue black clay	24	121
		gray rock	8"	
		ice series of		
		thin blue		
		tan gray rock		
		and blue clay	8	129
		gray sand with		
		black mixture		E2
		and gray shell	22	151
		sand blue		
		clay black		Excess
		speck mixture	91	172
		" " "	10	182
		fine white		
		sand	15	197
		hard pan	4"	
		sand blue clay		
		mixture	10	207
		white sand		
		with black speck		
		mixture	12	219
		hard pan	3"	
		white coarse sand	25	244
				13
				Well No.


Information upon completion of well:

- (1) Diameter 2 inches.
- (2) Total Depth 244 feet.
- (3) Water level 48 feet below top of ground.
- (4) Cased to 189, Size \_\_\_\_\_
- (5) Screen: Size 1/4, Length 6'
- (6) Were any formations sealed against pollution?  
\_\_\_\_\_ yes, no no.

If YES depth of formation \_\_\_\_\_

Why \_\_\_\_\_

Drillers Remarks: \_\_\_\_\_

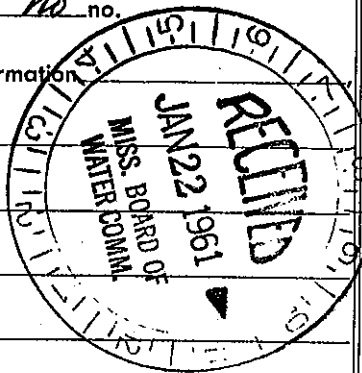

(Use Back Side)

Mail this copy to Board of Water Commissioners 429 Miss. St. Jackson, Miss.