

L25

ATTALA

L 25
9-67

MISSISSIPPI BOARD OF WATER COMMISSIONERS

CODED


Completed 4/23/68

WATER WELL DRILLERS LOG

CODED 80

Date: Sept 17, 1966, Driller: Brunwell Dwy County Attala
0093 (Name)

(1) Owner of Land: <u>M^cAdams Com.</u> (Name)	Description & Color of Materials Sand, Clay, Red Clay, Shell, etc.	Thick-ness Feet	Depth Feet
<u>M^cAdams</u> (Address)	<u>Red Clay</u>	<u>0</u>	<u>10</u>
(2) Location: <u>1/4, 1/4, Sec 35 14^N 6^E</u>	<u>White Chalk</u>	<u>10</u>	<u>21</u>
<u>1/4</u> miles <u>NW</u> of <u>M^cAdams</u> (distance) (direction) (Nearest Town)	<u>Black shale</u>	<u>21</u>	<u>120</u>
(3) Topography: <u>Hilly</u> (Hilly) (Flat) (Level)	<u>Soft Rock</u>	<u>120</u>	<u>124</u>
(4) Purpose of Well: <u>Community water system</u> (Domestic Irrigation, Municipal, Industrial, Other)	<u>Shale</u>	<u>124</u>	<u>150</u>
<u>TEST</u> Information upon completion of well:	<u>Hard Rock</u>	<u>150</u>	<u>158</u>
(1) Diameter <u>2</u> inches.	<u>Shale</u>	<u>158</u>	<u>180</u>
(2) Total Depth <u>609</u> feet.	<u>Hard Rock</u>	<u>180</u>	<u>189</u>
(3) Water Level <u>40</u> feet below top of ground.	<u>Shale</u>	<u>189</u>	<u>231</u>
(4) Cased to <u>504</u> , Size <u>2"</u>	<u>Sand & Shale</u>	<u>231</u>	<u>294</u>
(5) Screen: Size <u>Perforator to 600</u>	<u>Thin sand</u>	<u>294</u>	<u>315</u>
(6) Were any formations sealed against pollution? <u>no.</u>	<u>Rock ledge</u>	<u>315</u>	<u>358</u>
If YES depth of formation <u>315</u>	<u>Rocky shale & sand</u>	<u>358</u>	<u>423</u>
Why <u>Iron to high 0.8</u>	<u>sand & shale</u>	<u>423</u>	<u>504</u>
Drillers Remarks:	<u>TEST</u>	<u>504</u>	<u>588</u>
<u>CO₂ - 7.1</u>	<u>TEST</u>	<u>588</u>	<u>609</u>
<u>3.0.7</u>	<u>RECEIVED</u>	<u>609</u>	
<u>alk 9.5</u>	<u>SEP 18 1966</u>		
<u>Ph 7.3</u>	<u>MISS. BOARD OF WATER COM.</u>		
<u>(Electric Log)</u>			
Retain this copy for your office files.	<u>Well No.</u>		

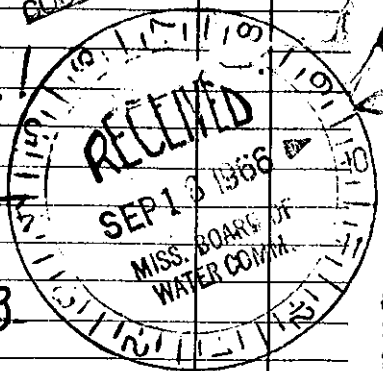

(Use Back Side)