


ATTALA
L 2000
3-21-62

COMMISSIONERS

WATER WELL DRILLERS LOG

Date: 3-21, 1962, Driller: Smith & Parsley County Attala
(Name)

(1) Owner of Land: <u>Clige Fuller</u> <small>(Name)</small>	Description & Color of Materials Sand, Clay, Red Clay, Shell, etc.	Thick- ness Feet	Depth Feet
<u>P.O. Sallis miss</u> <small>(Address)</small>	<u>Yellow Clay</u>	<u>15</u>	<u>15</u>
(2) Location: <u>2 5/8 SW 1/4, Sec. 10 T13 R6</u>	<u>Yellow sand</u>	<u>2</u>	<u>17</u>
<u>3</u> miles <u>N</u> , of <u>McAdams</u> <small>(distance) (direction) (Nearest Town)</small>	<u>Yellow Clay</u>	<u>2</u>	<u>19</u>
(3) Topography: <u>Hilly medium</u> <small>(Hilly) (Flat) (Level)</small>	<u>Yellow Clay</u>		
(4) Purpose of Well: <u>Domestic</u> <small>(Domestic Irrigation Municipal, Industrial, Other)</small>	<u>Coarse sand mixture</u>	<u>21</u>	<u>40</u>
Information upon completion of well:	<u>White sand</u>	<u>40</u>	<u>80</u>
(1) Diameter: <u>2</u> inches.			
(2) Total Depth: <u>80</u> feet.			
(3) Water Level: <u>36</u> feet below top of ground.			
(4) Cased to: <u>60</u> , Size: <u>2"</u>			
(5) Screen: Size: <u>1/4</u> , Length: <u>16'</u>			
(6) Were any formations sealed against pollution? _____ yes, <u>X</u> no.			
If YES depth of formation _____			
Why _____			
Drillers Remarks: _____ _____			

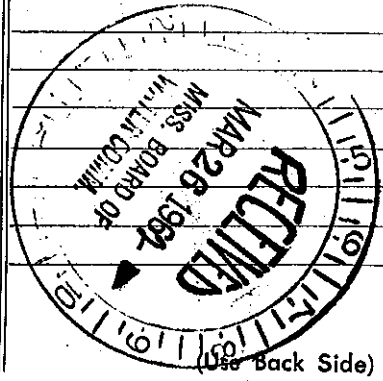

Well No. 20

Mail this copy to Board of Water Commissioners 429 Miss. St. Jackson, Miss.