


ATTALA MISSISSIPPI BOARD OF COMMISSIONERS

L 7001

7-24-62 WATER WELL DRILLERS LOG

Date: 7-24, 1962, Driller: Thomas & Son County ATTALA
(Name)

(1) Owner of Land: <u>C. J. Taylor</u> <small>(Name)</small>	Description & Color of Materials Sand, Clay, Red Clay, Shell, etc.	Thick- ness Feet	Depth Feet
<u>Kosciusko Miss</u> <small>(Address)</small>	<u>Red clay</u> <u>SAND</u>	<u>20</u>	<u>0-20</u>
(2) Location: <u>NE 1/4, SE 1/4, Sec. 35 T4R6,</u> <u>3</u> miles <u>west</u> of <u>Kosciusko,</u> <small>(distance) (direction) (Nearest Town)</small>			
(3) Topography: <u>Hilly</u> <small>(Hilly) (Flat) (Level)</small>			
(4) Purpose of Well: <u>Domestic</u> <small>(Domestic Irrigation Municipal, Industrial, Other)</small>			
Information upon completion of well:			
(1) Diameter <u>2</u> inches.			
(2) Total Depth <u>36</u> feet.			
(3) Water Level <u>20</u> feet below top of ground.			
(4) Cased to <u>30 Ft.</u> , Size <u>2"</u>			
(5) Screen: Size <u>60</u> , Length <u>6 Ft.</u>			
(6) Were any formations sealed against pollution? _____ yes, <u>✓</u> no.			
If YES depth of formation _____			
Why _____			
Drillers Remarks: _____			

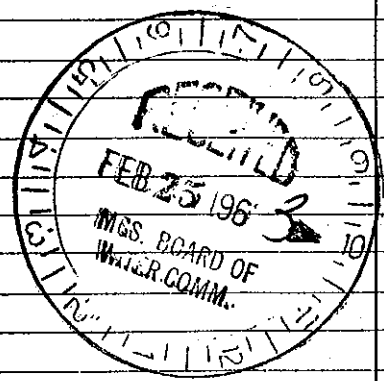

(Use Back Side)

Well No.

Mail this copy to Board of Water Commissioners 429 Miss. St. Jackson, Miss.