

L 2004
 4-7-63

WATER WELL DRILLERS LOG

Date: 4-7, 1963, Driller: Thomas & Son County Attala
 (Name)

| (1) Owner of Land: <u>J. B. Hester</u> (Name) <u>Kosciusko, Miss.</u> 1 A. (Address) | Description & Color of Materials Sand, Clay, Red Clay, Shell, etc. | Thick- ness Feet | Depth Feet |
|--|---|------------------------|---------------|
| | | <u>Red Clay</u> | <u>15</u> |
| | <u>Sand</u> | <u>48</u> | <u>63</u> |
| | | | |
| | | | |
(2) Location: W 1/2 SW 1/4, Sec. 36 T14R6
1/4 miles west, of Kosciusko
 (distance) (direction) (Nearest Town)

(3) Topography: Hilly
 (Hilly) (Flat) (Level)

(4) Purpose of Well: Domestic
 (Domestic Irrigation
 Municipal, Industrial, Other)

Information upon completion of well:

(1) Diameter 2 inches.

(2) Total Depth 63 feet.

(3) Water Level 35 feet below top of ground.

(4) Cased to 57, Size 2


(5) Screen: Size 60B, Length 6 Ft.

(6) Were any formations sealed against pollution?
 _____ yes, no.

If YES depth of formation _____

Why _____

Drillers Remarks: _____

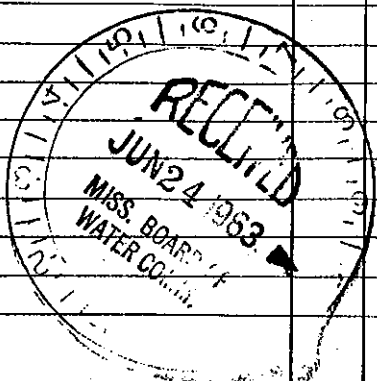

(Use Back Side)

Well No. _____