

ATTALA MISSISSIPPI BOARD OF WATER COMMISSIONERS

L 2008
4-29-63

WATER WELL DRILLERS LOG

Date: 4-29, 1963, Driller: Smith & Presley County Attala
(Name)

	Description & Color of Materials Sand, Clay, Red Clay, Shell, etc.	Thick- ness Feet	Depth Feet
(1) Owner of Land: <u>Mr John H Jones</u> (Name)	<u>light yellow clay</u>	<u>8</u>	<u>8</u>
<u>Mc Adams Miss</u> (Address)	<u>white fine sand</u>	<u>10</u>	<u>18</u>
(2) Location: <u>W 2 1/4 S E 1/4 1/4, Sec. 33 T14R6</u>	<u>yellow clay</u>	<u>18</u>	<u>36</u>
<u>in Mc Adams</u>	<u>blue clay</u>	<u>24</u>	<u>60</u>
miles of _____ (distance) (direction) (Nearest Town)	<u>black clay</u>	<u>60</u>	<u>120</u>
(3) Topography: _____ (Hilly) (Flat) (Level)	<u>hard rock</u>	<u>6"</u>	
(4) Purpose of Well: <u>domestic</u> (Domestic Irrigation Municipal, Industrial, Other)	<u>black clay</u>	<u>3</u>	<u>123</u>
	<u>rock sinter</u>	<u>6</u>	<u>129</u>
	<u>black</u>	<u>10</u>	<u>139</u>
	<u>green sand</u>	<u>11</u>	<u>150</u>
	<u>hard rock</u>		


Information upon completion of well:

- (1) Diameter 2 inches.
- (2) Total Depth 200 feet.
- (3) Water Level flowing feet below top of ground.
- (4) Cased to 84, Size 2
- (5) Screen: Size no; Length no
- (6) Were any formations sealed against pollution?
 yes, no.

If YES depth of formation _____

Why _____

Drillers Remarks: _____

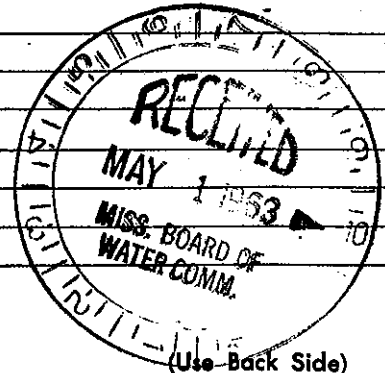

Well No. 41

Mail this copy to Board of Water Commissioners 429 Miss. St. Jackson, Miss.