

ATTALA MISSISSIPPI BOARD OF WATER COMMISSIONERS

L 2009
7-14-66

WATER WELL DRILLERS LOG

Date: 7-14, 1966, Driller: Smith Forge & Welding County: Attala
(Name)

		Description & Color of Materials Sand, Clay, Red Clay, Shell, etc.	Thick- ness Feet	Depth Feet
(1) Owner of Land: <u>RC Lallas</u> (Name) <u>Kosciusko miss</u> (Address)		<u>red clay</u>	<u>18</u>	<u>18</u>
(2) Location: <u>2 1/4 NW 1/4, Sec 25 T14R6</u> <u>2</u> miles <u>SW</u> of <u>Kosciusko</u> (distance) (direction) (Nearest Town)		<u>dry red sand</u>	<u>30</u>	<u>48</u>
(3) Topography: <u>hilly</u> (Hilly) (Flat) (Level)		<u>red sand</u>	<u>22</u>	<u>80</u>
(4) Purpose of Well: <u>domestic</u> (Domestic Irrigation Municipal, Industrial, Other)		<u>sand rock</u>	<u>4"</u>	<u>80</u>
		<u>red sand</u>	<u>28</u>	<u>108</u>
		<u>iron sand rock</u>	<u>6'</u>	
		<u>blue clay</u>	<u>10</u>	<u>118</u>
		<u>blue clay fine</u>		
		<u>gray sand mixture</u>	<u>32</u>	<u>150</u>
		<u>1/2" thick of gray</u>		
		<u>sand about</u>	<u>6</u>	<u>156</u>
		<u>hard rock</u>	<u>8</u>	
		<u>gray sand blue</u>		
		<u>clay mixture</u>	<u>14</u>	<u>170</u>
		<u>red rock</u>	<u>8</u>	<u>178</u>
		<u>black clay</u>	<u>23</u>	<u>195</u>
		<u>rock series thin</u>	<u>13</u>	<u>208</u>
		<u>black clay</u>	<u>10</u>	<u>218</u>
		<u>gray sand fine</u>		
		<u>clay mixture</u>	<u>18</u>	<u>226</u>
		<u>hard rock gray</u>	<u>2</u>	<u>228</u>
		<u>gray clay</u>	<u>7</u>	<u>235</u>
		<u>1/2" series of thin</u>		
		<u>rock</u>	<u>12</u>	<u>246</u>
		<u>gray sand shale</u>	<u>8</u>	<u>254</u>
		<u>mixture</u>		
		<u>hard rock</u>	<u>18"</u>	<u>255</u>
		<u>gray sand and shale</u>	<u>18</u>	<u>274</u>
		<u>hard rock thin</u>		
		<u>sand shale mixture</u>	<u>10</u>	<u>284</u>
		<u>thin rock</u>		
		<u>a good grade of gray sand</u>	<u>14</u>	<u>308</u>
				<u>17</u>
				<u>No</u>

Information upon completion of well:

(1) Diameter 2 inches.

(2) Total Depth 300 feet.

(3) Water Level 150 feet below top of ground.

(4) Cased to 294, Size 2


(5) Screen: Size 1/4, Length 6'

(6) Were any formations sealed against pollution?
 yes, no

If YES depth of formation _____

Why _____

Drillers Remarks: Pump 40 GPH
225 GPH
Etc

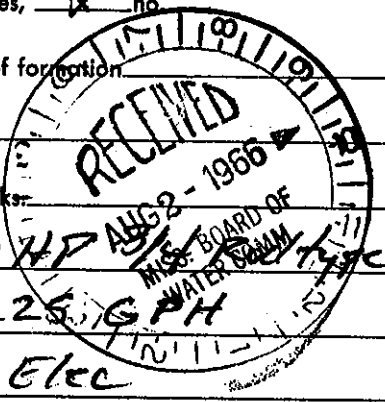

(Use Back Side)

Mail this copy to Board of Water Commissioners 429 Miss. St. Jackson, Miss.