

Attala
 22010
 7-66

MISSISSIPPI BOARD OF WATER COMMISSIONERS

WATER WELL DRILLERS LOG

Date: 7-22, 1966, Driller: Thomas & Son County Attala
(When well drilled) (Name) (Where well is located)

(1) Owner of Land	Description & Color of Materials Sand, Clay, Red Clay, Shell, etc.	Thick- ness Feet	Depth Feet
<u>Mrs. C. B. Fox</u> <small>(Name)</small>	<u>Dry Sand</u>	<u>90</u>	<u>0</u>
<u>Kosciusko, Miss.</u> <small>(Address)</small>	<u>Coarse Sand</u>	<u>25</u>	<u>90</u>
(2) Location: <u>NW 1/4, SE 1/4, Sec. 24 T14R3E</u> <u>1</u> miles <u>W</u> of <u>Kos.</u> <small>(distance) (direction) (Nearest Town)</small>	<u>Black Dirt</u>	<u>50</u>	<u>115</u>
	<u>Rock & Shell</u>	<u>30</u>	<u>165</u>
	<u>Green Sand</u>	<u>38</u>	<u>195</u>
(3) Topography: <input checked="" type="radio"/> <u>Hilly</u> <input type="radio"/> Flat <input type="radio"/> Level			
(4) Purpose of Well: <input checked="" type="radio"/> Domestic <input type="radio"/> Irrigation <input type="radio"/> Municipal, Industrial, Other			

Information upon completion of well:

- (1) Diameter 2 inches.
- (2) Total Depth 233 feet.
- (3) Water Level 150 feet below top of ground.
- (4) Cased to 168, Size 2"
- (5) Screen: Size None, Length _____
- (6) Were any formations sealed against pollution?
 _____ yes, no.

If YES depth of formation _____


Why _____

Drillers Remarks: _____

Yield in gpm: 5

Size pump: 2 H.P. 35tg.

Type power: Elec

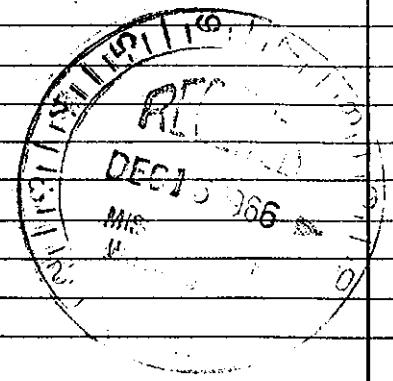

Mail this copy to Board of Water Commissioners 429 Miss. St. Jackson, Miss.