

ATTALA
L 2012
2-68

MISSISSIPPI
BOARD OF WATER COMMISSIONERS
416 North State Street
Jackson, Mississippi 39201

WATER WELL DRILLERS LOG

2-21 1968 Thomas & Son ATTALA
date well completed firm name county well located


LANDOWNER: Markon Ivey
Kosciusko, Miss.
(mailing address)

WELL LOCATION:
sec. 3 T. 40 S. R. 60 W.
5 miles NW of Kos
(distance) (direction) (nearest town)

WELL PURPOSE:
(home) irrigation, municipal, industrial

- WELL COMPLETION DATA:
- (1) diameter (inches) 2
 - (2) total depth (feet) 150
 - (3) static water level (feet) 29 ^{below} ~~above~~ top of ground.
 - (4) casing S&W 63'
(material) (depth)
2"
(size) if telescope see back.
 - (5) screen None
(length) (depth to top)
Open
(size) (material)
 - (6) pump 3/4 10
(HP) (yield gpm)
Elec
(type power)
 - (7) electric log No
(yes or no)
(organization running log)
 - (8) how well bottom plugged

description of formations encountered	from	to
Pipe Clay	0	21
Yellow Sand	21	26
Black Dirt	26	42
Rock & Shell	42	66
Shell & Filling	66	80
Green Sand	80	150
with str. Black Dirt		

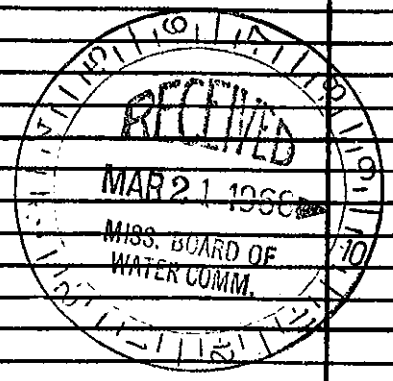

DRILLERS REMARKS: