

ATTALA  
 L 2013  
 3-68

MISSISSIPPI  
 BOARD OF WATER COMMISSIONERS  
 416 North State Street  
 Jackson, Mississippi 39201

WATER WELL DRILLERS LOG

3-8 1968 Thomastson ATTALA  
 date well completed firm name county well located


LANDOWNER: Bailey Howard  
Kosciusko, Miss.  
 (mailing address)

| description of formations encountered | from | to |
|---------------------------------------|------|----|
| Dirt                                  | 0    | 15 |
| SAND                                  | 15   | 42 |

WELL LOCATION:  
 sec. 23 T-14 N R-6 E  
 S W  
3 miles West of Kos.  
 (distance) (direction) (nearest town)

WELL PURPOSE:  
 (home, irrigation, municipal, industrial)

WELL COMPLETION DATA:  
 (1) diameter (inches) 2  
 (2) total depth (feet) 42  
 (3) static water level (feet) 15 Below top of ground.  
 (4) casing Galv. 37  
 (material) (depth)  
2' If telescope see back.  
 (size)  
 (5) screen 5' 37  
 (length) (depth to top)  
1/4 slot, Stainless Steel  
 (size) (material)  
 (6) pump 1/2 6  
 (HP) (yield gpm)  
Elec  
 (type power)  
 (7) electric log no  
 (yes or no)  
 (organization running log)  
 (8) how well bottom plugged

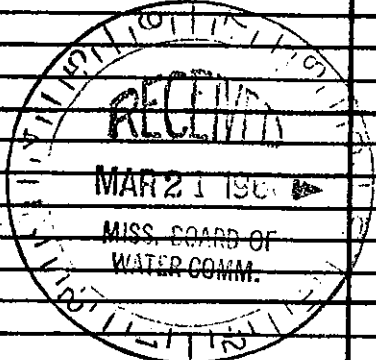

DRILLERS REMARKS: