

MISSISSIPPI BOARD OF WATER COMMISSIONERS

2020  
8-24-62

WATER WELL DRILLERS LOG

Date: 8-24, 1962, Driller: J P Thornton County St. Louis  
(Name)

(1) Owner of Land: (Name) (Address)	Description & Color of Materials Sand, Clay, Red Clay, Shell, etc.	Thick- ness Feet	Depth Feet
Leon Adams	red clay	30	
Muscumbe Miss	sand rock	3	
	Black dirt	50	
(2) Location: 1/4, 1/4, Sec. T R	Rock	4	
2 1/2 miles South of Muscumbe	Black Charcoal	8	
(distance) (direction) (Nearest Town)	Shell & sand	12	
(3) Topography: Hilly	dark sand	20	
(Hilly) (Flat) (Level)	rock	3	
(4) Purpose of Well: Domestic	pink chalk	8	
(Domestic Irrigation Municipal, Industrial, Other)	water gray sand	16	
			154


Information upon completion of well:

- (1) Diameter 2" inches.
- (2) Total Depth 154 feet.
- (3) Water Level 60 feet below top of ground.
- (4) Cased to 147, Size 2"
- (5) Screen: Size 1 1/4, Length 6 ft
- (6) Were any formations sealed against pollution?  
\_\_\_\_\_ yes, \_\_\_\_\_ no.

If YES depth of formation \_\_\_\_\_

Why \_\_\_\_\_

Drillers Remarks: 380 gal per hr

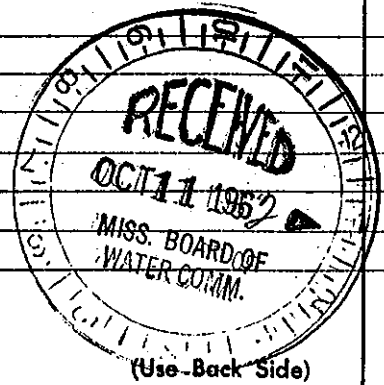

Well No.

Mail this copy to Board of Water Commissioners 429 Miss. St. Jackson, Miss