

ATTALA MISSISSIPPI BOARD OF WATER COMMISSIONERS

M 59
2-14-64

WATER WELL DRILLERS LOG

CODED

Date: 2-14-1964, Driller: Layne-Central Co. County Attala

(Name)

(1) Owner of Land: City of Kosciusko
(Name)
Kosciusko, Mississippi
(Address)

(2) Location: 1/4, 1/4, Sec. 20 T14R7,
_____ miles _____ of _____
(distance) (direction) (Nearest Town)

(3) Topography: _____
(Hilly) (Flat) (Level)

(4) Purpose of Well: municipal
(Domestic Irrigation
Municipal, Industrial, Other)

Description & Color of Materials Sand, Clay, Red Clay, Shell, etc.	Thick- ness Feet	Depth Feet
sandy clay	10	10
fine red sand	16	26
hard shale	37	63
sandy shale	3	66
boulders-rock	4	70
hard shale	18	88
boulders	4	92
fine sand	8	100
muddy sand	31	131
muddy sand-gumbo	100	231
shale-stks sand	34	265
hard shale	35	300
shale-stks sand stone	48	348
medium sand	24	372
coarse sand	76	448
sand-med stks shale	3	451

Information upon completion of well:

(1) Diameter 18 inches.

(2) Total Depth 446' feet.

(3) Water Level 145' feet below top of ground.

(4) Cased to 375', Size 18"


(5) Screen: Size 10", Length 60'

(6) Were any formations sealed against pollution?
X yes, _____ no.

If YES depth of formation 375'

Why required

Drillers Remarks: _____

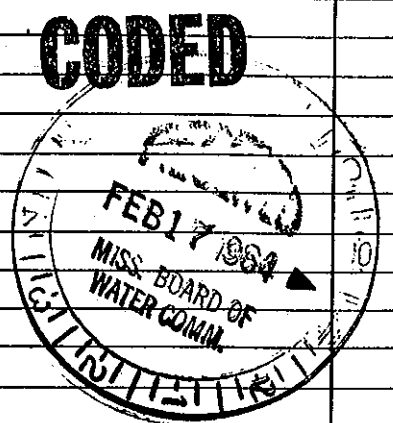

(Use Back Side)

Well No.

Mail this copy to Board of Water Commissioners 429 Miss. St. Jackson, Miss