

ATTALA MISSISSIPPI BOARD OF WATER COMMISSIONERS

M 68
8-4-60

WATER WELL DRILLERS LOG **CODED**

Date: 8-4, 1960, Driller: R. P. Nicholas county Neshoba
(Name)

(1) Owner of Land: Miss. Forestry
(Name)
Atalla County
(Address)

(2) Location: NW 1/4, NW 1/4, Sec. 18 T14R7
_____ miles _____ of Kosciusko
(distance) (direction) (Nearest Town)

(3) Topography: Hilly
(Hilly) (flat) (Level)

(4) Purpose of Well: home use
(Domestic Irrigation
Municipal, Industrial, Other)

Description & Color of Materials Sand, Clay, Red Clay, Shell, etc.	Thick- ness Feet	Depth Feet
<u>Clay</u>	<u>1</u>	<u>30</u>
<u>Shell rock & Clay</u>	<u>30</u>	<u>80</u>
<u>Sand</u>	<u>80</u>	<u>153</u>
<u>blue dirt</u>	<u>153</u>	<u>183</u>
<u>rock</u>	<u>183</u>	<u>201</u>
<u>blue dirt & sand</u>	<u>200</u>	<u>293</u>
<u>rock</u>	<u>293</u>	<u>305</u>
<u>blue dirt & sand</u>	<u>305</u>	<u>393</u>
<u>rock</u>	<u>393</u>	<u>413</u>
<u>water sand</u>	<u>413</u>	<u>435</u>

Information upon completion of well:


- (1) Diameter 4 1/2 inches.
- (2) Total Depth 435 feet.
- (3) Water Level 300 feet below top of ground.
- (4) Cased to bottom Size 2"
- (5) Screen: Size 10, Length 15
- (6) Were any formations sealed against pollution?
 yes, _____ no.

If YES depth of formation 153 ft

Why Water was no good

Drillers Remarks: well has
183 ft - 4" pipe in
it, to case off sand
and water.

CODED

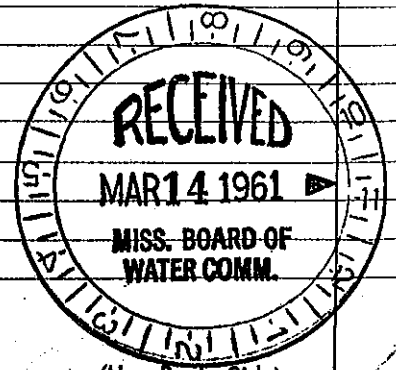

Mail this copy to Board of Water Commissioners 429 Miss. St. Jackson, Miss.