

ATTALA MISSISSIPPI BOARD OF WATER COMMISSIONERS

M 2000

M 300

WATER WELL DRILLERS LOG

7-13-60

Date: 7-13-1960, Driller: Smith & Presley County ATTALA

(Name)

(1) Owner of Land: <u>Nois Malone</u> (Name)	Description & Color of Materials Sand, Clay, Red Clay, Shell, etc.	Thick- ness Feet	Depth Feet
<u>Kosciusk Miss</u> (Address)	<u>Red sand</u>	20	20
8721 1st St <u>N E</u>	<u>White sand</u>	8	28
(2) Location: <u>1/4 NW 1/4, Sec. 19 T14R7</u>	<u>White Clay & trace of sand</u>	6	34
<u>1</u> miles <u>West</u> of <u>Kosciusko</u> (distance) (direction) (Nearest Town)	<u>White sand</u>	14	48
(3) Topography: <u>Hilly</u> (Hilly) (Flat) (Level)	<u>White sand mixed with white clay</u>	11	59
(4) Purpose of Well: <u>Domestic</u> (Domestic Irrigation Municipal, Industrial, Other)	<u>Coarse white water sand</u>	10	69


Information upon completion of well:

- (1) Diameter 2" inches.
- (2) Total Depth 70 feet.
- (3) Water Level 50 feet below top of ground.
- (4) Cased to 63', Size 2"
- (5) Screen: Size 1 1/4, Length 6"
- (6) Were any formations sealed against pollution?
_____ yes, X no.

If YES depth of formation _____

Why _____

Drillers Remarks: _____

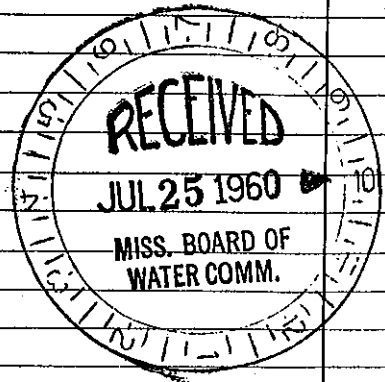

(Use Back Side)

Well No. 2

Mail this copy to Board of Water Commissioners 429 Miss. St. Jackson, Miss.