


ATTALA
M 2001

MISSISSIPPI BOARD OF WATER COMMISSIONERS

3-14-62 WATER WELL DRILLERS LOG

Date: 3-14, 1962 Driller: Smith & Prealey County Attala
 (Name)

(1) Owner of Land: <u>Viola Garland</u> (Name)	Description & Color of Materials Sand, Clay, Red Clay, Shell, etc.	Thick- ness Feet	Depth Feet
(2) Location: <u>8 1/2</u> <u>1/4</u> , <u>E 1/2</u> <u>82 1124</u> , <u>1 3/4</u> miles <u>North</u> <u>Co.</u> , of <u>Kosciusko</u> (distance) (direction) (Nearest Town)	Top soil Red Clay	6	6
(3) Topography: <u>Hilly</u> (Hilly) (Flat) (Level)	red sand	11	17
(4) Purpose of Well: <u>domestic</u> (Domestic Irrigation Municipal, Industrial, Other)	blue or black clay	21	38
Information upon completion of well:	hard shale	3"	
(1) Diameter <u>2</u> inches.	black clay	1	39
(2) Total Depth <u>174</u> feet.	gray rock	12"	40
(3) Water Level <u>75</u> feet below top of ground.	blue or black clay	2	42
(4) Cased to <u>149</u> , Size <u>2</u>	green clay and a trace of sand		
(5) Screen: Size <u>1/4</u> , Length <u>6"</u>	granulated char		
(6) Were any formations sealed against pollution? yes, <u>X</u> no.	coal like mixture	5	47
If YES depth of formation	brown clay	7	54
Why	light green clay	6	60
Drillers Remarks:	light green shale	6"	
	green clay	6	66
	green sand with a black mixture		
	and shell white	39	105
	green sand black mixture	13	118
	black clay	20	138
	hard shale	4"	
	black clay mixture of sand	18	156
	hard fine black clay	6	162
	very good grad of water sand	12	174

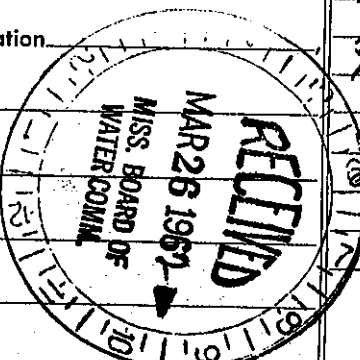

(Use Back Side)

Mail this copy to Board of Water Commissioners 429 Miss. St. Jackson