

ATTALA MISSISSIPPI BOARD OF WATER COMMISSIONERS

M 2583

10-29-62

WATER WELL DRILLERS LOG

Date: 10-29, 1962, Driller: THOMAS & SON County ATTALA
(Name)

(1) Owner of Land: <u>A.P. Williams</u> <small>(Name)</small>	Description & Color of Materials Sand, Clay, Red Clay, Shell, etc.	Thick- ness Feet	Depth Feet
<u>Kosciusko, Miss</u> <small>(Address)</small>	<u>Red Clay</u>	<u>10</u>	<u>0-10</u>
(2) Location: <u>N 1/4, SE 1/4, Sec. 25 T14R7,</u>	<u>SAND</u>	<u>25</u>	<u>10</u>
<u>3</u> miles <u>S. EAST</u> of <u>Kosciusko</u> <small>(distance) (direction) (Nearest Town)</small>	<u>BLACK DIRT</u>	<u>30</u>	<u>35</u>
(3) Topography: <u>Hilly</u> <small>(Hilly) (Flat) (Level)</small>	<u>Rock & Shell</u>	<u>25</u>	<u>65</u>
(4) Purpose of Well: <u>Domestic</u> <small>(Domestic Irrigation Municipal, Industrial, Other)</small>	<u>Green Sand (Dry)</u>	<u>20</u>	<u>90</u>
	<u>Grey Green Sand</u>	<u>37</u>	<u>110</u>


Information upon completion of well:

- (1) Diameter 2 inches.
- (2) Total Depth 146 feet.
- (3) Water Level 103 feet below top of ground.
- (4) Cased to 134, Size 2.
- (5) Screen: Size 60, Length 12 FT.
- (6) Were any formations sealed against pollution?
 yes, no.

If YES depth of formation _____

Why _____

Drillers Remarks: _____

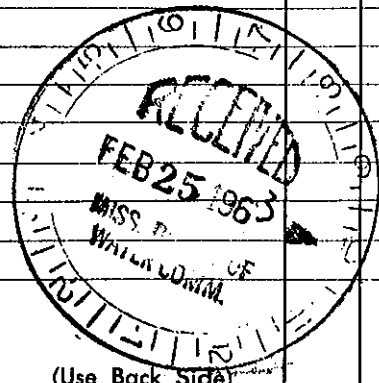

(Use Back Side)

Well No.

Mail this copy to Board of Water Commissioners 429 Miss. St. Jackson, Miss.