

M ATTALA  
 2005  
 2-22-63

WATER WELL DRILLERS LOG


Date: 2-22, 1963, Driller: Thomas & Son County: Attala  
 (Name)

(1) Owner of Land: Jim Mangrum  
 (Name)  
Kosciusko, Miss.  
 (Address)  
South End  
 (2) Location: SW 1/4, 1/4, Sec. 5 T14R7  
1 1/2 miles North, of Kosciusko  
 (distance) (direction) (Nearest Town)  
 (3) Topography: Hilly  
 (Hilly) (Flat) (Level)  
 (4) Purpose of Well: Domestic  
 (Domestic Irrigation  
 Municipal, Industrial, Other)

Description & Color of Materials Sand, Clay, Red Clay, Shell, etc.	Thick- ness Feet	Depth Feet
Red clay	10	0-10
Black Dirt	20	30
Rock + shell <sup>Blue</sup> dirt	15	45
Red Coarse meal Sand	25	70
Green Sand w/ chalk	20	90
Blue dirt little sand	20	110
Coarse Blue Sand	30	140
Blue chalk + Rock	15	150
Coarse Blue-Green Sand	21	176

Information upon completion of well:

(1) Diameter 2 inches.  
 (2) Total Depth 176 feet.  
 (3) Water Level 25 feet below top of ground.  
 (4) Cased to 140, Size 2  
 (5) Screen: Size \_\_\_\_\_, Length \_\_\_\_\_  
 (6) Were any formations sealed against pollution?  
 \_\_\_\_\_ yes,  no.  
 If YES depth of formation \_\_\_\_\_  
 Why \_\_\_\_\_  
 Drillers Remarks: \_\_\_\_\_  
 \_\_\_\_\_  
 \_\_\_\_\_

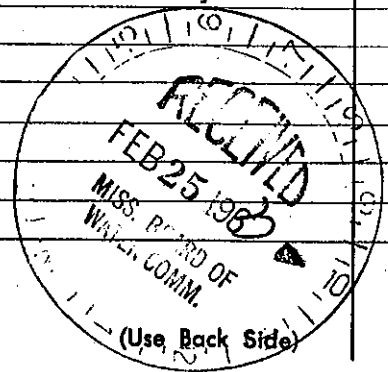

Well No.

~~Return this copy to your office.~~