

MISSISSIPPI BOARD OF WATER COMMISSIONERS



ATTALA

M 2013  
9-23-64

WATER WELL DRILLERS LOG

Date: 9-23, 19 64, Driller: Smith & Presley County Attala  
(Name)

(1) Owner of Land: <u>Henry Bann</u> (Name)	Description & Color of Materials Sand, Clay, Red Clay, Shell, etc.	Thick- ness Feet	Depth Feet
<u>R. I. Kosciusko Miss</u> (Address)	red clay	8	8
(2) Location: <u>Sec. 12, NW 1/4, T14R 7, R20E</u>	red sand	12	20
<u>4</u> miles <u>East</u> of <u>Kosciusko</u> (distance) (direction) (Nearest Town)	white and red clay mixture	6	26
(3) Topography: <u>Hilly</u> (Hilly) (Flat) (Level)	brown clay		
(4) Purpose of Well: <u>Domestic</u> (Domestic Irrigation Municipal, Industrial, Other)	sponge sand		
Information upon completion of well:	black speck mixture	3	29
(1) Diameter <u>2</u> inches.	sand rock	9	38
(2) Total Depth <u>153</u> feet.	brown sand	9	47
(3) Water Level <u>84</u> feet below top of ground.	clay mixture	9	47
(4) Cased to <u>147</u> , Size <u>2</u>	sand rock	1	48
(5) Screen: Size <u>1/4</u> , Length <u>6'</u>	sand clay and a fine coal like mixture	12	60
(6) Were any formations sealed against pollution? yes, <u>no</u>	blue clay sand mixture	3	63
If YES depth of formation	blue clay with a trace of sand	20	83
Why	red rock	1	84
Drillers Remarks:	sand	3	87
for a good grade of white sand	blue clay white or shell mixture	90	107
for a good grade of white sand	white sand		
for a good grade of white sand	blue clay mixture in and out for a	30	137
for a good grade of white sand	for a good grade of white sand	16	153
for a good grade of white sand			
for a good grade of white sand			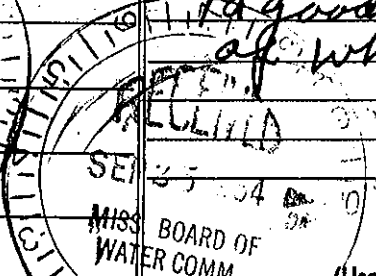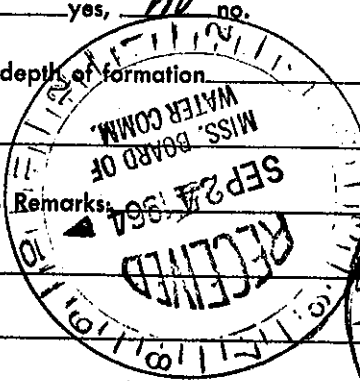
(Use Back Side)

Mail this copy to Board of Water Commissioners 429 Miss. St. Jackson, Miss.

504  
7