


ATTALA MISSISSIPPI BOARD OF WATER COMMISSIONERS

M 2014
2-7-66

WATER WELL DRILLERS LOG

Date: 2-7-66, 1966, Driller: Smith Forge & Well County Attala
(Name)

(1) Owner of Land: <u>Robert M Alston</u> (Name)	Description & Color of Materials Sand, Clay, Red Clay, Shell, etc.	Thick- ness Feet	Depth Feet
<u>Kosciusko Miss</u> (Address)	<u>Clay</u>	<u>3</u>	<u>3</u>
(2) Location: <u>118</u> $\frac{1}{4}$, <u>118</u> $\frac{1}{4}$, Sec. <u>30</u> T <u>14</u> R <u>7E</u>	<u>Red sand</u>	<u>27</u>	<u>30</u>
<u>1/2</u> miles <u>South</u> of <u>Kosciusko</u> (distance) (direction) (Nearest Town)	<u>White sand</u>	<u>10</u>	<u>40</u>
(3) Topography: <u>Hilly</u> (Hilly) (Flat) (Level)			
(4) Purpose of Well: <u>Domestic</u> (Domestic Irrigation Municipal, Industrial, Other)			
Information upon completion of well:			
(1) Diameter <u>2</u> inches.			
(2) Total Depth <u>40</u> feet.			
(3) Water Level <u>30</u> feet below top of ground.			
(4) Cased to <u>35</u> , Size <u>2</u>			
(5) Screen: Size <u>1 1/4</u> , Length <u>57</u>			
(6) Were any formations sealed against pollution? <u>no</u> yes, <u>X</u> no.			
If YES depth of formation _____			
Why _____			
Drillers Remarks: _____			

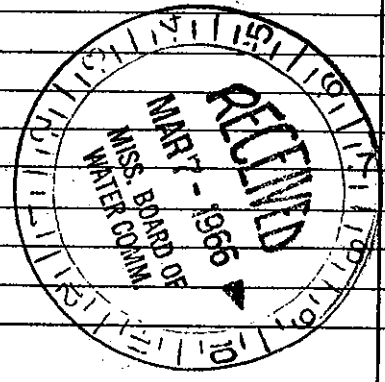

(Use Back Side)

Well No. 1

Mail this copy to Board of Water Commissioners 429 Miss. St. Jackson, Miss