

Attala

M 2016

9-66 MISSISSIPPI BOARD OF WATER COMMISSIONERS


WATER WELL DRILLERS LOG

Date: 9-27, 1966, Driller: Thomas & Son County ATTALA

Form with fields for Owner of Land (Mr. E. Edwards), Location (SW 1/4, NW 1/4, Sec. 19 T14R7), Topography (Hilly), Purpose of Well (Domestic Irrigation), and a table for Description & Color of Materials (Dry Sand, Coarse Sand, Black Dirt, Rock & Shell, Green Sand) with Thickness and Depth columns.

Information upon completion of well: (1) Diameter 2 inches, (2) Total Depth 234 feet, (3) Water Level 251 feet below top of ground, (4) Cased to 176, Size 2", (5) Screen: Size None, Length, (6) Were any formations sealed against pollution? yes, [checked] no.

If YES depth of formation, Why, Drillers Remarks, Yield in gpm: 5, Size pump: 2 H.P. 3 stg., Type power: Elec

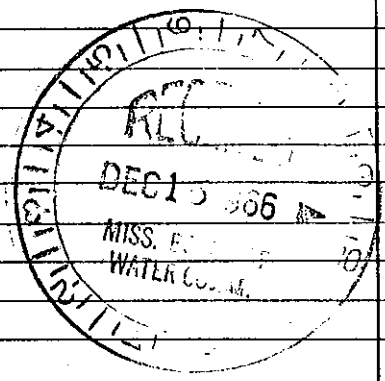

Mail this copy to Board of Water Commissioners 429 Miss. St. Jackson, Miss.