

Attala

M 2017

11-66 MISSISSIPPI BOARD OF WATER COMMISSIONERS

WATER WELL DRILLERS LOG

Date: 11-30, 1966, Driller: Thomas S. Son County, ATTALA


Owner of Land: MR. EVANS, NW 1/4, SW 1/4, Sec. 3 T14R7, Kosciusko, Miss. Location: 2 miles N of Kosciusko. Purpose of Well: Domestic Irrigation.

Table with 3 columns: Description & Color of Materials, Thickness Feet, Depth Feet. Entries include: 0-15 ft Clay, 15-15 ft Black Dirt, 15-30 ft Rock & Shell, 30-70 ft Shell w/ some green sand, 70-110 ft coarse grey sand.

Information upon completion of well:

- (1) Diameter 2 inches. (2) Total Depth 120 feet. (3) Water Level 55 feet below top of ground. (4) Cased to 115', Size 2". (5) Screen: Size 8 slot, Length 5'. (6) Were any formations sealed against pollution? no.

If YES depth of formation... Why... Drillers Remarks: Yield in gpm: 7, Size pump: 3/4 H.P., Type power: Elec.

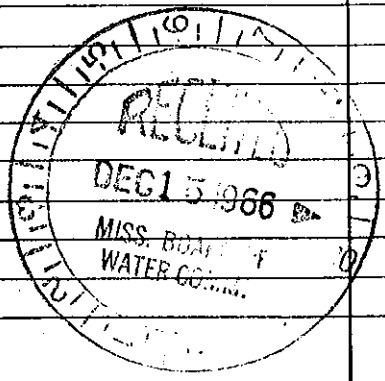

Mail this copy to Board of Water Commissioners 429 Miss. St. Jackson, Miss.