

Attala
 M 2018
 12-66

MISSISSIPPI BOARD OF WATER COMMISSIONERS

WATER WELL DRILLERS LOG


Date: 12-22, 1966, Driller: Thomas & Son County ATTALA
(When well drilled) (Name) (Where well is located)

		Description & Color of Materials Sand, Clay, Red Clay, Shell, etc.	Thick- ness Feet	Depth Feet
(1) Owner of Land: <u>Mrs. Joiner</u> <small>(Name)</small>				
<u>Kosciusko, Miss.</u> <small>(Address)</small>		<u>Dry Sand</u> <u>Coarse Sand</u>	<u>30</u> <u>0</u>	<u>0</u> <u>30</u>
(2) Location: <u>NW 1/4, NE 1/4, Sec. 30</u> <u>1/2 miles W of Kosciusko</u> <small>(distance) (direction) (Nearest Town)</small>				
(3) Topography: <u>(Hilly)</u> (Flat) (Level)				
(4) Purpose of Well: <u>(Domestic)</u> Irrigation Municipal, Industrial, Other				

Information upon completion of well:

- (1) Diameter 2 inches.
- (2) Total Depth 43 feet.
- (3) Water Level 30 feet below top of ground.
- (4) Cased to 37, Size 2
- (5) Screen: Size 606, Length 6 ft.
- (6) Were any formations sealed against pollution?
 _____ yes, no.

If YES depth of formation _____
 Why _____
 Drillers Remarks: _____
 Yield in gpm: 4
 Size pump: 1/2 H.P. Rod
 Type power: Elec.

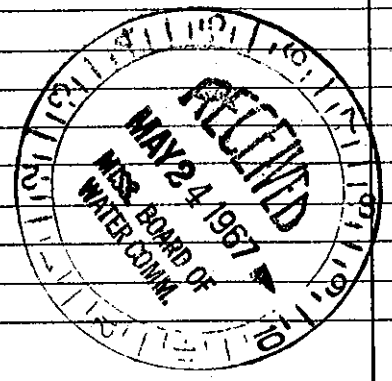

Mail this copy to Board of Water Commissioners 429 Miss. St. Jackson, Miss.