

Attala
M 2021
3-67

MISSISSIPPI
BOARD OF WATER COMMISSIONERS
416 North State Street
Jackson, Mississippi 39201
WATER WELL DRILLERS LOG

3-2 19 67 Thomas & Son Attala
date well completed firm name county well located

LANDOWNER: American Legion
SKATING RINK


Kosciusko, Miss.
(mailing address)

WELL LOCATION:
sec. 3 T 14 N R 7 E
S W
3 miles N of Kos.
(distance) (direction) (nearest town)

WELL PURPOSE: Home
(home, irrigation, municipal, industrial)

- WELL COMPLETION DATA:
- (1) diameter (inches) 2
 - (2) total depth (feet) 145
 - (3) static water level (feet) 93 below above top of ground.
 - (4) casing GALV. 1 1/2 (material) (depth)
2" (size) if telescope see back.
 - (5) screen 5 Ft. 142 (length) (depth to top)
1 1/4" STAINLESS STEEL (size) (material)
 - (6) pump 1/2 (HP) 4 (yield gpm)
Elec. Rod Pump (type power)
 - (7) electric log NO (yes or no)
(organization running log)
 - (8) how well bottom plugged

description of formations encountered	from	to
Red Clay	0	25
White Chalk	25	40
Black Dirt	40	50
10 Inch Rock	50	
Black dirt	51	65
Rock & Shell	65	95
Green Sand w/ lots of Filling	95	100
Green Sand	100	120
Grey Sand	120	145
Real course at Bottom		

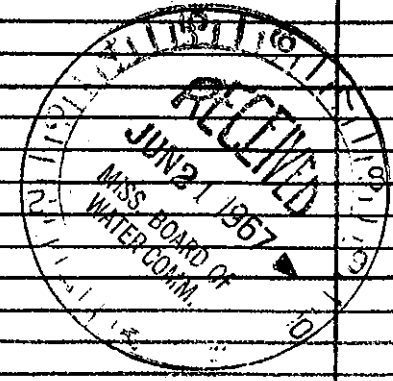

DRILLERS REMARKS: