

135

ATTALA
N 18
10-19-68

MISSISSIPPI
BOARD OF WATER COMMISSIONERS
416 North State Street
Jackson, Mississippi 39201

CODED

WATER WELL DRILLERS LOG

10-19 1968 Thomas & Son ATTALA
date well completed firm name county well located

LANDOWNER: Mr. A. Rone
Ethel, Miss.
(mailing address)


description of formations encountered	from	to
DIRT	0	20
Red Sand	20	60
CHALK	60	65
Coarse sand	65	69
Mostly Chalk	69	71

WELL LOCATION:
sec. 10 T. 14 N R. 8 E
S W
2 miles S of Ethel
(distance) (direction) (nearest town)

WELL PURPOSE:
(Home, irrigation, municipal, industrial)

- WELL COMPLETION DATA:
- (1) diameter (inches) 2
 - (2) total depth (feet) 71
 - (3) static water level (feet) 50 ⁶⁶ _{above} top of ground.
 - (4) casing PVC, 65,
(material) (depth)
2" if telescope see back.
(size)
 - (5) screen 6, 65
(length) (depth to top)
1 1/4 - 8 slot BRASS
(size) (material)
 - (6) pump 3/4, 6
(HP) (yield gpm)
Elec
(type power)
 - (7) electric log NO
(yes or no)
(organization running log)
 - (8) how well bottom plugged _____

CODED

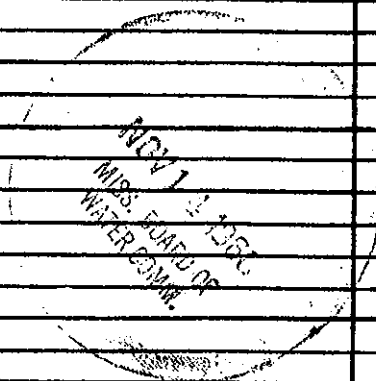

DRILLERS REMARKS: