

ATTALA

WATER WELL DRILLERS LOG

N 2000  
 Date: 1-12-63, 1963, Driller: Thomas & Son County Attala  
 (Name)

		Description & Color of Materials Sand, Clay, Red Clay, Shell, etc.	Thick- ness Feet	Depth Feet
(1) Owner of Land: <u>M. L. Dollarhide</u> (Name)		<u>Red Clay</u>	<u>40</u>	<u>0</u>
<u>Kosciusko, Miss</u> (Address)		<u>Chalk &amp; Shell</u>	<u>30</u>	<u>40</u>
(2) Location: <u>1/4, NE 1/4, Sec. 34, T14R8,</u>		<u>Fine Blue Sand</u>	<u>37</u>	<u>70</u>
<u>10 miles S-E</u> , of <u>Kosciusko</u> (distance) (direction) (Nearest Town)		<u>Blue Dirt</u>	<u>8</u>	<u>107</u>
(3) Topography: <u>Hilly</u> (Hilly) (Flat) (Level)		<u>Fine To Coarse Sand</u>	<u>32</u>	<u>135</u>
(4) Purpose of Well: <u>Domestic</u> (Domestic Irrigation Municipal, Industrial, Other)		<u>Blue Chalk</u>	<u>6</u>	<u>142</u>
		<u>Coarse Blue Sand</u>	<u>11</u>	<u>153</u>
				<u>164</u>


Information upon completion of well:

- (1) Diameter 2 inches.
- (2) Total Depth 164 feet.
- (3) Water Level 7.5 feet below top of ground.
- (4) Cased to 153, Size 2
- (5) Screen: Size 60, Length 11 ft.
- (6) Were any formations sealed against pollution?  
 yes,  no.

If YES depth of formation \_\_\_\_\_

Why \_\_\_\_\_

Drillers Remarks: \_\_\_\_\_

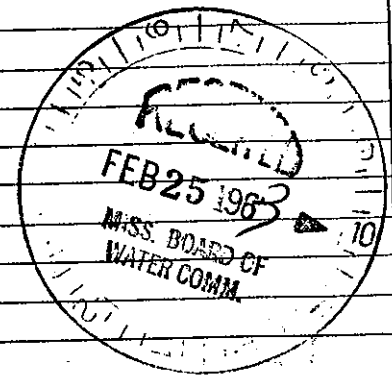

(Use Back Side)

Well No.

~~retain this copy for your office files.~~