

ATTALA MISSISSIPPI BOARD OF WATER COMMISSIONERS

N 2001

WATER WELL DRILLERS LOG

4-28-63

Date: 4-28, 1963, Driller: Thomas & Son County Attala
(Name)

		Description & Color of Materials Sand, Clay, Red Clay, Shell, etc.	Thick- ness Feet	Depth Feet
(1) Owner of Land:	<u>E. McGary Jr.</u> <small>(Name)</small>	<u>Red CLAY</u>	<u>15</u>	<u>0-15</u>
	<u>Kosciusko Rt. #1</u> <small>(Address)</small>	<u>SAND ROCK CHALK</u>	<u>30</u>	<u>45</u>
(2) Location:	<u>SW 1/4, SE 1/4, Sec. 29 T14R 8,</u>	<u>Red SAND w/DIRT (Mud)</u>	<u>10</u>	<u>55</u>
	<u>5 1/2 miles EAST</u> of <u>Kosciusko,</u>	<u>Grey SAND w/Blue mud</u>	<u>82</u>	<u>137</u>
	<small>(distance) (direction) (Nearest Town)</small>	<u>HARD Blue DIRT</u>	<u>7</u>	<u>144</u>
(3) Topography:	<u>Hilly</u> <small>(Hilly) (Flat) (Level)</small>	<u>Real coarse white SAND</u>	<u>6</u>	<u>150</u>
(4) Purpose of Well:	<u>Domestic</u> <small>(Domestic Irrigation Municipal, Industrial, Other)</small>			


Information upon completion of well:

- (1) Diameter 2 inches.
- (2) Total Depth 150 feet.
- (3) Water Level 82 feet below top of ground.
- (4) Cased to 144 Size 2"
- (5) Screen: Size 85/100, Length 5 FT.
- (6) Were any formations sealed against pollution?
 yes, no.

If YES depth of formation _____

Why _____

Drillers Remarks: _____

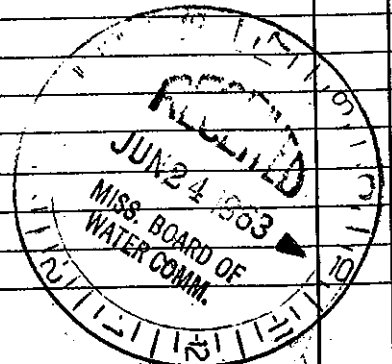

(Use Back Side)

Well No.

Mail this copy to Board of Water Commissioners 429 Miss. St. Jackson, Miss