

ATTALA MISSISSIPPI BOARD OF WATER COMMISSIONERS

N 2004  
1-3-66

WATER WELL DRILLERS LOG

Date: 1-3, 1966, Driller: Thomas & Son County ATTALA  
(Name)

		Description & Color of Materials Sand, Clay, Red Clay, Shell, etc.	Thick- ness Feet	Depth Feet
(1) Owner of Land: <u>Mr. Blaine</u> (Name)		<u>Red clay</u>	<u>30</u>	<u>0</u>
<u>Kosciusko, Miss</u> (Address)		<u>Chalk w/ some sand</u>	<u>60</u>	<u>30</u>
(2) Location: <u>SW 1/4, NW 1/4, Sec. 36 T. 14 R. 9</u>		<u>Mostly sand</u>	<u>92</u>	<u>60</u>
<u>9</u> miles <u>E</u> of <u>Kosciusko</u> (distance) (direction) (Nearest Town)		<u>w/ some chalk</u>		
(3) Topography: <u>(Hilly)</u> (Flat) (Level)				
(4) Purpose of Well: <u>(Domestic)</u> Irrigation Municipal, Industrial, Other				


Information upon completion of well:

- (1) Diameter 2 inches.
- (2) Total Depth 82 feet.
- (3) Water Level 60 feet below top of ground.
- (4) Cased to 76', Size 2"
- (5) Screen: Size 60 mesh length 6 Ft.
- (6) Were any formations sealed against pollution?  
\_\_\_\_\_ yes, X no.

If YES depth of formation \_\_\_\_\_

Why \_\_\_\_\_

Drillers Remarks: \_\_\_\_\_

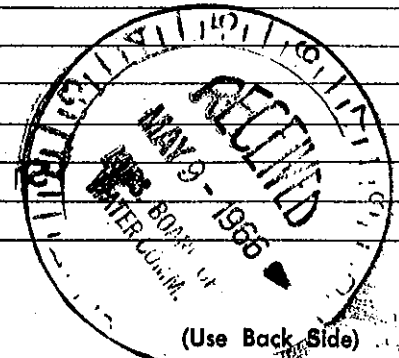

Well No.

Mail this copy to Board of Water Commissioners 429 Miss. St. Jackson, Miss.