

ATTALA MISSISSIPPI BOARD OF WATER COMMISSIONERS

N 2005
5-25-66

WATER WELL DRILLERS LOG

Date: 5-25, 1966, Driller: Thomas & Son County ATTALA
(Name)

		Description & Color of Materials Sand, Clay, Red Clay, Shell, etc.	Thick- ness Feet	Depth Feet
(1) Owner of Land:	Mr. R. Pope (Name)	Pipe Clay	20	0
	Rt. 1 Kosciusko, Miss. (Address)	Red meal SAND	35	20
(2) Location:	SW 1/4, NE 1/4, Sec. 36 T14R8. (distance) (direction) (Nearest Town)	yellow SAND	14	55
	7 miles S.E. of Kosciusko	Fine Blue Sand + Chalk	36	69
(3) Topography:	(Hilly) (Flat) (Level)	Black Dirt	10	105
(4) Purpose of Well:	Domestic Irrigation Municipal, Industrial, Other)	Mostly Rock + Blue Chalk	73	115
		Coarse white Sand	7	188


Information upon completion of well:

- (1) Diameter 2 inches.
- (2) Total Depth 195 feet.
- (3) Water Level 110 feet below top of ground.
- (4) Cased to 189', Size 2"
- (5) Screen: Size 60 G., Length 6 Ft.
- (6) Were any formations sealed against pollution?
_____ yes, no.

If YES depth of formation _____

Why _____

Drillers Remarks: _____

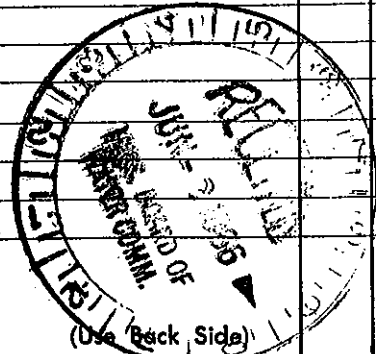

Well No. _____

Mail this copy to Board of Water Commissioners 429 Miss. St. Jackson, Miss.