

Attala
N 2857

12-66 MISSISSIPPI BOARD OF WATER COMMISSIONERS

WATER WELL DRILLERS LOG

Date: 12-2, 1966, Driller: Thomas S. Soy County Attala
(When well drilled) (Name) (Where well is located)

(1) Owner of Land:	Description & Color of Materials Sand, Clay, Red Clay, Shell, etc.	Thick-	Depth
		ness	Feet
<u>Mr. J. McGary</u> (Name) <u>Kosciusko, Miss</u> (Address)	<u>Red Clay</u>	<u>15</u>	<u>2</u>
	<u>Yellow Sand</u>	<u>5</u>	<u>15</u>
	<u>Coarse Sand & some Chalk</u>	<u>17</u>	<u>20</u>

(2) Location: NE 1/4, SW 1/4, Sec. 15 T14R8
7 miles E of Kosciusko
(distance) (direction) (Nearest Town)

(3) Topography: (Hilly) (Flat) (Level)

(4) Purpose of Well: (Domestic Irrigation)
Municipal, Industrial, Other

Information upon completion of well:

- (1) Diameter 2 inches.
- (2) Total Depth 37 feet.
- (3) Water Level 20 feet below top of ground.
- (4) Cased to 32', Size 2"
- (5) Screen: Size 8.5/64, Length 5 FT.
- (6) Were any formations sealed against pollution?
_____ yes, ✓ no.

If YES depth of formation _____


Why _____

Drillers Remarks: _____

Yield in gpm: 5

Size pump: 1/2 H.P.

Type power: Elec

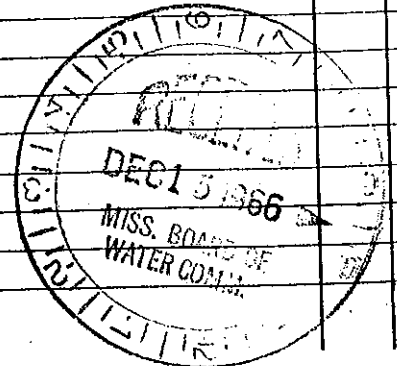

Mail this copy to Board of Water Commissioners 429 Miss. St. Jackson, Miss.