

Φ 19  
 Attala  
 4/1/75

MISSISSIPPI  
 BOARD OF WATER COMMISSIONERS  
 416 North State Street  
 Jackson, Mississippi 39201


WATER WELL DRILLERS LOG

CODED

4-1-1975 JHM Donald firm name Attala county well located

LANDOWNER: <u>Bill Edwards</u>	description of formations encountered	from	to
<u>Louisville Miss</u>			
(mailing address)	<u>red clay</u>	<u>0</u>	<u>22</u>
	<u>sand &amp; clay</u>	<u>22</u>	<u>54</u>
	<u>gray clay</u>	<u>54</u>	<u>190</u>
	<u>gray fine sand</u>	<u>190</u>	<u>220</u>
	<u>gray m. sand</u>	<u>220</u>	<u>240</u>
<b>WELL LOCATION:</b> sec. <u>24</u> T. <u>14</u> N. R. <u>9</u> E. S. <u>5</u> W. <u>15</u> miles <u>East</u> of <u>Nosciola</u> (distance) (direction) (nearest town)			
<b>WELL PURPOSE:</b> <u>Home</u> (home, irrigation, municipal, industrial)			
<b>WELL COMPLETION DATA:</b> (1) diameter (inches) <u>4"</u> (2) total depth (feet) <u>240</u> (3) static water level (feet) <u>110</u> below above top of ground. (4) casing <u>PVC</u> <u>220</u> (material) (depth) <u>4"</u> if telescope see back. (size) (5) screen <u>10'</u> <u>240-230</u> (length) (depth to top) <u>2</u> <u>Galat SS</u> (size) (material) (6) pump <u>2</u> <u>8</u> (HP) (yield gpm) <u>electric</u> (type power) (7) electric log <u>no</u> (yes or no) (organization running log) (8) how well bottom plugged _____			
<b>DRILLERS REMARKS:</b> _____			

CODED

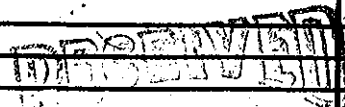

MAY 27 1975

MISS. BO. OF WATER COMM