

ATTA LA

P16

MISSISSIPPI BOARD OF WATER COMMISSIONERS

4-16-65


WATER WELL DRILLERS LOG

CODED

Date: 4/16, 1965, Driller: McKey County: ATTA LA

230

		Description & Color of Materials Sand, Clay, Red Clay, Shell, etc.	Thick- ness Feet	Depth Feet
(1) Owner of Land: <u>S A T H O M A S</u> (Name)	<u>Goodman</u> (Address)	Clay	0	20
(2) Location: <u>1/4, 1/4, Sec. 27 T13R4</u>	<u>7</u> miles <u>SE</u> , of <u>Goodman</u> (distance) (direction) (Nearest Town)	Sand	20	30
(3) Topography: <input checked="" type="checkbox"/> (Level)		Clay	30	60
(4) Purpose of Well: <u>Home</u> (Domestic Irrigation, Municipal, Industrial, Other)		Clay (fine slow)	60	140
		Sand (coarse)	140	290
		Clay	290	294
		Clay - Sand Str	294	300
		Coarse Sand	300	340
		Clay - Rock	340	460
		Clay - Hard Rock	460	500
		Clay	500	540
		Semi Rock	540	560
		Shell and Rock	560	860
		Fine Sand	860	880
		Fine Sand	880	920
		Clay	920	980
Information upon completion of well:		<p>Pulled Back to 315 ft well flowing 5 gal/min from sand at 315 ft</p> <p>STOCK PIPE AND BROKE N 315 to 980 Left Pipe in Hole</p>		
(1) Diameter <u>4x2</u> inches.				
(2) Total Depth <u>315</u> feet.				
(3) Water Level <u>Flow</u> feet below top of ground.				
(4) Cased to <u>296</u> , Size <u>4"</u>				
(5) Screen: Size <u>0010</u> , Length <u>10 ft 53</u>				
(6) Were any formations sealed against pollution? <input type="checkbox"/> yes, <input checked="" type="checkbox"/> no.				
If YES depth of formation _____				
Why _____				
Drillers Remarks: _____				

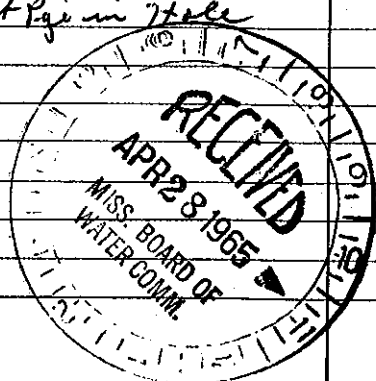

(Use Back Side)

Well No.

Mail this copy to Board of Water Commissioners 429 Miss. St. Jackson, Miss.