

ATTALA
P20
5-8-74

MISSISSIPPI
 BOARD OF WATER COMMISSIONERS
 416 North State Street
 Jackson, Mississippi 39201

CODED
 ATTALA
 to take
 county well located

WATER WELL DRILLERS LOG
 5-8-74 THOMAS + SON
 date well completed firm name


LANDOWNER: **S.D. CAIN**
 ≈ 320'
Sallis, Miss.
 (mailing address)
 WELL LOCATION:
 sec. 12 T. 13 N. R. 4 E
5 miles SW of SALLIS
 (distance) (direction) (nearest town)

WELL PURPOSE: DRY
 (home, irrigation, municipal, industrial)

WELL COMPLETION DATA:
 (1) diameter (inches) 2
 (2) total depth (feet) 545
 (3) static water level (feet) 76 below above
 top of ground.
 (4) casing CAV. 420
 (material) (depth)
2
 (size) if telescope see back.
 (5) screen open
 (length) (depth to top)
 (size) (material)
 (6) pump 1 1
 (HP) (yield gpm)
elec.
 (type power)
 (7) electric log no
 (yes or no)
 (organization running log)
 (8) how well bottom plugged open

description of formations encountered	from	to
Red Clay	0	3
Brown Clay + Sand	3	35
Black Dirt	35	83
Sand	83	103
Grey Chalk + Sand	103	147
Sand	147	214
Grey Chalk	(214)	25
Course Sand	332	338
Black Dirt	338	420
Rock Black Dirt	420	462
Rock	462	47
Green Sand	470	545

CODED

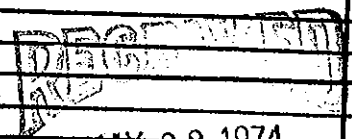

MAY 22 1974

DRILLERS REMARKS: