

County: Attala  
 Permit #: \_\_\_\_\_  
 Driller: Thomas Drilling  
 Date drilling completed: 10-18-04

### Well Driller Report and Well Log

Mississippi Department of Environmental Quality  
 Office of Land and Water Resources  
 P.O. Box 10631  
 Jackson, MS 39289-0631  
 (601)961-5210  
 (601)354-6938 (fax)

For Office Use Only:  
 Aquifer: \_\_\_\_\_  
 Well #: P-31  
 L. S. Elevation: \_\_\_\_\_  
 E-log #: \_\_\_\_\_

State Law requires that this report be prepared by the driller in detail and filed with the Department within 30 days of completion of drilling of the well.

Well Owner Information	Well Location
Owner Name: <u>Bill Walker</u>	Latitude: <u>N 32° 54.57'</u> Longitude: <u>89° 50.88'</u>
Mailing Address: _____	Method of Lat/Long (circle one): Conventional Survey, _____
_____	USGS quad, <u>Hand-held GPS</u> , Survey-grade GPS _____
City _____ State _____ Zip Code _____	<u>SE</u> 1/4 <u>SE</u> 1/4 Sec <u>2</u> Twn <u>12 N</u> Rng <u>4 E</u>
Telephone No. <u>(888) 378-2266</u>	Distance <u>5</u> Miles Direction <u>West</u> of Nearest Town <u>New Port</u>

**Well Data**

Purpose of Well (circle one) Home Industrial Public Supply Irrigation Fish Culture Other: Farm

Date well drilling started: 10-15-04 Date well drilling completed: 10-18-04

If flowing, method of flow regulation: Valve \_\_\_\_\_ Other (describe) \_\_\_\_\_

Static Water Level: 97 feet above or below (circle one) land surface Date measured: 10-18-04

Method of Measurement (circle one) steel tape electric tape air line other: \_\_\_\_\_

Hole depth: 205 Well depth: 205 Well grouted to a depth of 10 feet

Type of grout (circle one): Cement Bentonite Mix

Casing length: 195 feet Casing diameter: 4x2 inches Type of casing: PVC

Screen length: 10 feet Screen diameter: 2" inches Type of screen: PVC WOP

Screen slot size: .010 inches Setting depth: From 195 feet to 205 feet

Type of completion (circle all applicable): Gravel packed Underreamed Telescoped Open hole Natural Development

Other (describe): \_\_\_\_\_

Top of lap pipe or reduction in casing: 175 feet. If telescoped or more than one screen, describe on back of page

Logs run (circle all applicable): No log run Electric Gamma Ray Density Sonic Neutron Other: \_\_\_\_\_

Name of organization running log(s): \_\_\_\_\_

I certify that the well was drilled, constructed, and completed in accordance with all applicable requirements of the Mississippi Department of Environmental Quality and/or the Mississippi Department of Health regulations and state laws.

David S. Thomas 0-147 David S. Thomas  
 Print Name of Water Well Contractor and License No. Signature of Water Well Contractor

If well telescopes please sketch below and show depths.

RECEIVED  
 NOV 16 2004  
 BY: OLWR



**STATE WELL REPORT**

**Part 2**

**Pump Installer's Completion Report**

Mississippi Department of Environmental Quality  
Office of Land and Water Resources  
P.O. Box 10631  
Jackson, MS 39289-0631  
(601)961-5210  
(601)354-6938 (fax)

For Office Use Only:

Aquifer: \_\_\_\_\_  
 Well #: P-31  
 Elevation: \_\_\_\_\_

County: ATTALA  
 Permit #: \_\_\_\_\_  
 Driller: THOMAS Drilling  
 Date completed: 10-18-04

**This report must be prepared by the pump installer in detail and filed with the Department within 30 days of the installation of pump. A copy of Part 1 of this report must be attached to this report.**

Well Owner Information	Well Location
Owner Name: <u>Bill Walker</u>	Latitude: <u>N 32° 54.579</u> Longitude: <u>W 89° 50.831</u>
Mailing Address: _____	Method of Lat/Long (circle one): Conventional Survey,
_____	USGS quad, <u>Hand-held GPS</u> , Survey-grade GPS
City _____ State _____ Zip Code _____	<u>SE</u> ¼ <u>SE</u> ¼ Sec <u>2</u> Twn <u>12N</u> Rng <u>4E</u>
Telephone No. <u>(888) 378-2266</u>	Distance _____ Direction _____ Nearest Town _____
	<u>5</u> Miles <u>West</u> of <u>Newport</u>

Pump Type Circle one	Power Type Circle one
Air Lift      Jet <u>Submersible</u> Bucket      Piston      Turbine Centrifugal      Rotary      Flowing Well Other (specify): _____	Diesel Engine      Gasoline Engine      Natural Gas <u>Electric Motor</u> Hand      Tractor PTO Windmill      Other (specify): _____ Horse Power Rating of Motor: <u>1/2</u>
Date Pump Installed: <u>10-18-04</u>	Setting Depth: <u>140</u> feet
Rated Pump Capacity: <u>7</u> Gallons Per Minute	Number of Stages: <u>7</u>

Pump Test Data	Method of Measuring Water Level Circle one
Date Well Tested: <u>10-18-04</u>	<u>Air Line</u> Electric Measuring Line      Steel Tape
Static Water Level (A): <u>97</u> Feet Below Land Surface	Other (specify): _____
Pumping Water Level (B): <u>~107</u> Feet Below Land Surface	For flowing well, measured shut in head: _____ feet
Drawdown [(B) - (A)]: <u>~10</u> Feet Below Land Surface	Well yielded _____ GPM with a drawdown of _____ feet after _____ hours of pumping
Test Pumping Rate: <u>10</u> Gallons Per Minute	
Duration of Pump Test (minimum 4 hours): <u>2</u> hours	

I HEREBY CERTIFY that the above statements are true to the best of my knowledge.

David S. Thomas 0-147  
Print Name of Pump Installer and License No. (if applicable)


David S. Thomas  
Signature of Pump Installer

RECEIVED

NOV 16 2004

BY: OLWR

# topozone

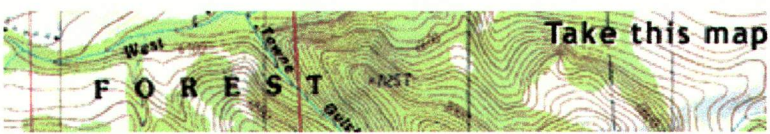

- VIEW MAPS
- GET DATA
- MY TOPOZONE
- WEB SERVICES
- ABOUT US

- Map/Photo Info
- Topo Download
- Photo Download

32° 54.58'N, 89° 50.83'W (WGS84/  
USGS Newport Quad

View TopoZone Pro aerial photos, shaded relief, street maps, interact

- USGS Topo Maps**
- 1:24K/25K Series
  - 1:100K Series
  - 1:250K Series
- Map Size**
- Small
  - Medium
  - Large
- View Scale**
- 1 : 50,000
- Update Map

- Coordinate Format**
- DD MM.MM
- Coordinate Datum**
- WGS84/NAD83
- Show target
- [Email this map](#)
- [Bookmark this map](#)
- [Print this map](#)

myTopo.com

GET A CUSTOM MAP PRINT

