

ATTALA

2000  
3-10-61

WATER WELL DRILLERS LOG

(0095) P12

Date: 3/10, 1961, Driller: Braswell, Del County, Attala  
(Name)

		Description & Color of Materials Sand, Clay, Red Clay, Shell, etc.	Thick- ness Feet	Depth Feet
(1) Owner of Land:	Oliver McCann (Name) Goodman Miss. (Address)	Red Clay White dirty Sand	40	40
(2) Location:	SE 1/4, SE 1/4, Sec. 33, T13R4E 2 1/2 miles East of Goodman (distance) (direction) (Nearest Town)	Hard Black Shale Green sand but dirty with shell & black flakes	430	470 87 574
(3) Topography:	Level (Hilly) (Flat) (Level)	Clean green sand	45	639
(4) Purpose of Well:	Domestic (Domestic Irrigation Municipal, Industrial, Other)		100	739

Information upon completion of well:


- (1) Diameter 2 inches.
- (2) Total Depth 739 feet.
- (3) Water Level overflow feet below top of ground.
- (4) Cased to 510, Size 2"
- (5) Screen: Size perforated to bottom length
- (6) Were any formations sealed against pollution?  
 yes,  no.

If YES depth of formation

Why

Drillers Remarks:

Well flows  
6' above ground  
Level with 1 1/4" choke  
at 12 G.P.M.

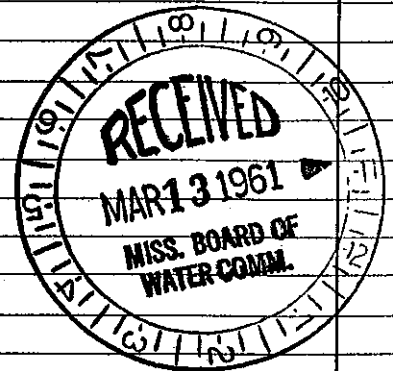

(Use Back Side)

Well No.

Mail this copy to Board of Water Commissioners 429 Miss. St. Jackson, Miss