


ATTALA MISSISSIPPI BOARD OF WATER COMMISSIONERS

P 2001
3-22-66

WATER WELL DRILLERS LOG

Date: 3-22, 1966, Driller: Thomas & Son County ATTALA
(Name)

| | Description & Color of Materials Sand, Clay, Red Clay, Shell, etc. | Thick- ness Feet | Depth Feet |
|--|---|--|---|
| (1) Owner of Land: <u>Mr. Ables</u> (Name) <u>Goodman, Miss.</u> (Address) | <u>Dirt</u> | <u>15</u> | <u>0</u> |
| (2) Location: <u>SE 1/4, SW 1/4, Sec. 23 T13R4</u> <u>3 1/2</u> miles <u>E</u> , of <u>Goodman</u> (distance) (direction) (Nearest Town) | <u>SAND (Coarse)</u> <u>CHALK & BLACK DIRT</u> <u>FINE SAND</u> <u>Coarse White SAND</u> | <u>10</u> <u>115</u> <u>15</u> <u>1.5</u> | <u>15</u> <u>2.5</u> <u>145</u> <u>160</u> |
| (3) Topography: <input checked="" type="radio"/> (Hilly) <input type="radio"/> (Flat) <input type="radio"/> (Level) | | | |
| (4) Purpose of Well: <input checked="" type="radio"/> (Domestic) <input type="radio"/> (Irrigation) <input type="radio"/> (Municipal) <input type="radio"/> (Industrial) <input type="radio"/> (Other) | | | |
| Information upon completion of well: | | | |
| (1) Diameter <u>2</u> inches. | | | |
| (2) Total Depth <u>175</u> feet. | | | |
| (3) Water Level <u>35'</u> feet below top of ground. | | | |
| (4) Cased to <u>169</u> , Size <u>2"</u> | | | |
| (5) Screen: Size <u>8 Slot</u> , Length <u>6 Ft.</u> | | | |
| (6) Were any formations sealed against pollution? <u>no</u> yes, <input checked="" type="checkbox"/> no. | | | |
| If YES depth of formation _____ | | | |
| Why _____ | | | |
| Drillers Remarks: _____ _____ _____ | | | |

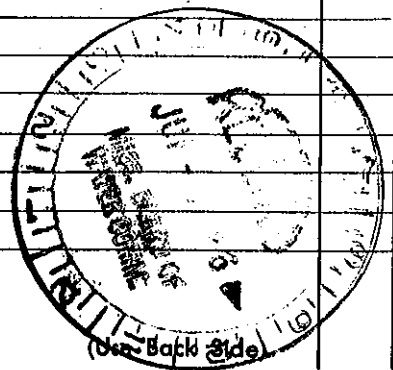

Well No.

Mail this copy to Board of Water Commissioners 429 Miss. St. Jackson, Miss.