


ATTALA MISSISSIPPI BOARD OF WATER COMMISSIONERS

P 2007  
11-9-66

WATER WELL DRILLERS LOG

Date: 11-9, 1966, Driller: Thomas & Son County Attala  
≈ 240' (Name)

		Description & Color of Materials Sand, Clay, Red Clay, Shell, etc.	Thick- ness Feet	Depth Feet
(1) Owner of Land: <u>Mr. McDaniel</u> <small>(Name)</small>		<u>CHALK</u>	<u>20</u>	<u>0</u>
<u>Goodman, Miss.</u> <small>(Address)</small>		<u>SAND</u>	<u>60</u>	<u>20</u>
(2) Location: <u>SE 1/4, SW 1/4, Sec. 4 T12R14</u>		<u>BLACK DIRT M</u>	<u>35</u>	<u>80</u>
<u>4</u> miles <u>S to S.E.</u> of <u>Goodman</u> <small>(distance) (direction) (Nearest Town)</small>		<u>Some streaks of sand</u>		<u>117.5</u>
(3) Topography: _____ <small>(Hilly) (Flat) (Level)</small>		<u>Pure Sand, Corser</u>	<u>165</u>	<u>175</u>
(4) Purpose of Well: _____ <small>(Domestic, Irrigation, Municipal, Industrial, Other)</small>		<u>At Bottom</u>		<u>175</u>
		<u>Hard Black Dirt</u>	<u>10</u>	<u>340</u>
		<u>SAND</u>	<u>10</u>	<u>350</u>
		<u>Sticky Black Dirt</u>	<u>10</u>	<u>360</u>
		<u>Pure Sand</u>	<u>142</u>	<u>370</u>
		<u>(Real Corser 490 to 504)</u>		
		<u>Hard Black Dirt</u>	<u>100</u>	<u>520</u>
		<u>Rock, shell &amp; Black</u>	<u>65</u>	<u>620</u>
		<u>Dirt. 1 Rock was 3 ft thru</u>		
		<u>At 675</u>		
		<u>Green Sand</u>	<u>70</u>	<u>695</u>
		<u>Stopped on Rock</u>		
Information upon completion of well:				
(1) Diameter <u>2</u> inches.				
(2) Total Depth <u>757</u> feet.				
(3) Water Level <u>Flows</u> feet below top of ground.				
(4) Cased to <u>546 ft</u> size <u>2"</u>				
(5) Screen: Size _____, Length _____				
(6) Were any formations sealed against pollution? _____ yes, <u>X</u> no.				
If YES depth of formation _____				
Why _____				
Drillers Remarks: _____				
_____				
_____				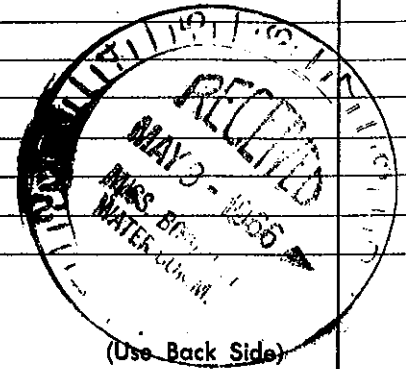
Well No.

Mail this copy to Board of Water Commissioners 429 Miss. St. Jackson, Miss.