

ATTALA MISSISSIPPI BOARD OF WATER COMMISSIONERS

Q32  
4-19-61


WATER WELL DRILLERS LOG **CODED**

Date: 4/18 & 4/19/1961, Driller: James McGee County Attala

(Name)

| Owner of Land: Charles Hudson<br>(Name)   | Description & Color of Materials<br>Sand, Clay, Red Clay, Shell, etc. | Thick-<br>ness<br>Feet | Depth<br>Feet |
|---|---|------------------------|---------------|
| Kosciusko, Miss.<br>(Address)   | Red clay.   | 0-                     | 12            |
| Take Hwy. 12 out of Kosciusko and<br>go to a little town called Sallis.<br>Turn South and go about 3 miles.<br>2 1/2 of 13.5<br>(distance) (direction) (Nearest Town) | Red sand.   | 12-                    | 22            |
| Topography: <input checked="" type="checkbox"/> (Hilly) <input type="checkbox"/> (Flat) <input type="checkbox"/> (Level)  | Clay & sand.  | 22-                    | 52            |
| Purpose of Well: Domestic.<br>(Domestic Irrigation<br>Municipal, Industrial, Other)   | Fine sand.  | 52-                    | 62            |
| Information upon completion of well:  | Fine sand & clay.   | 62-                    | 82            |
| (1) Diameter 2 inches.  | Fine sand.  | 82-                    | 162           |
| (2) Total Depth 467' feet.  | Dry sand.   | 162-                   | 262           |
| (3) Water Level 35' feet below top of ground.   | Clay.   | 262-                   | 358           |
| (4) Cased to 457', Size 2"  | Clay & stks. rock.  | 358-                   | 362           |
| (5) Screen: Size 2", Length 10'   | Shale.  | 362-                   | 372           |
| (6) Were any formations sealed against pollution?<br>_____ yes, <input checked="" type="checkbox"/> no.   | Shale & stks. rock.   | 372-                   | 402           |
| If YES depth of formation _____   | Clay & stks. sand.  | 402-                   | 422           |
| Why _____   | Fine sand.  | 422-                   | 452           |
| Drillers Remarks: Good well.  | Sand. (Screen setting)  | 452-                   | 467           |

**CODED**

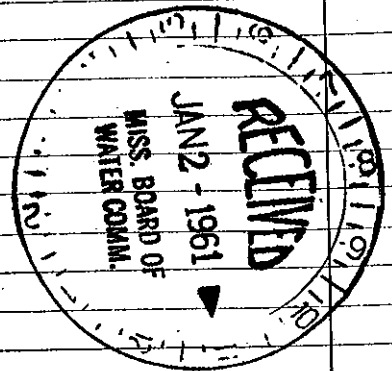

(Use Back Side)

Retain this copy for your office files.

Well No.