

ATTALA MISS

COMMISSIONERS

Q 35
9-15-60

WATER WELL DRILLERS LOG

0093

Q 27

Date: Sept. 15, 1960, Driller: Branwell Dyer County Attala
(Name)

(1) Owner of Land: G.H. Hutchison
(Name)
elev. 300

(2) Location: SW (Address) 34 13 N E
NE 1/4, SW 1/4, Sec 34 13 N E
8 miles SW, of Kosciusko
(distance) (direction) (Nearest Town)

(3) Topography: Flat
(Hilly) (Flat) (Level)

(4) Purpose of Well: Domestic
(Domestic Irrigation
Municipal, Industrial, Other)

Description & Color of Materials Sand, Clay, Red Clay, Shell, etc.	Thick- ness Feet	Depth Feet
<u>0-21 Red sand</u>	<u>21</u>	<u>21</u>
<u>White Chalk</u>	<u>21</u>	<u>42</u>
<u>Dull gray sand</u>		<u>29</u>
<u>White rock</u>	<u>14</u>	<u>309</u>
<u>Black shale</u>		<u>40</u>
<u>Dirty White sand</u>		<u>52</u>

Information upon completion of well:

(1) Diameter 2 1/2 inches.

(2) Total Depth 528 feet.

(3) Water Level Flowing feet below top of ground.

(4) Cased to 315, Size 2 1/2


(5) Screen: Size _____, Length _____

(6) Were any formations sealed against pollution?
_____ yes, no.

If YES depth of formation _____

Why _____

Drillers Remarks: _____

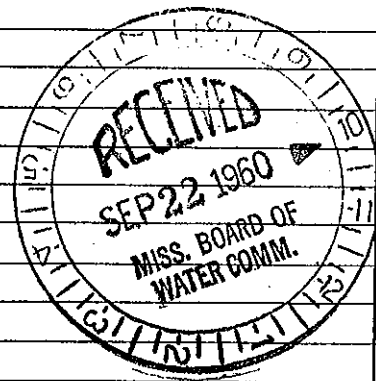

(Use Back Side)

Well No.

Mail this copy to Board of Water Commissioners 429 Miss. St. Jackson, Miss.