

ATTALA

MISSISSIPPI BOARD OF WATER COMMISSIONERS

Q 28

Q 2001

11-8-61

WATER WELL DRILLERS LOG

Attala

Date: 11-8, 1961, Driller: Jack Martin, County Attala

Elev. 320'

(Name)

		Description & Color of Materials Sand, Clay, Red Clay, Shell, etc.	Thick- ness Feet	Depth Feet
(1) Owner of Land: <u>Henry Baldridge</u> (Name)		Red clay	19	19
<u>Goodman Miss</u> (Address)		Sand - mud streak	47	66
(2) Location: <u>SW 1/4, SE 1/4, Sec. 17 T12 R5E</u>		Sand	8	74
<u>12</u> miles <u>East</u> , of <u>Goodman</u> (distance) (direction) (Nearest Town)		Sand - mud	21	95
(3) Topography: <u>7</u> (Hilly) (Flat) (Level)		Sand	20	115
(4) Purpose of Well: <u>Domestic</u> (Domestic Irrigation Municipal, Industrial, Other)		Mud	31	146
		Sand	9	151
		Mud	39	190
		Sand	110	300
		Mud	4	304
		Sand	21	325
		Mud	7	332
		Sand	73	405
		Mud	20	425
		Sand	23	448
		Mud	112	560
		Sand	60	620


Information upon completion of well:

- (1) Diameter 2 inches.
- (2) Total Depth 618 feet.
- (3) Water Level 40 feet below top of ground.
- (4) Cased to 603, Size 2
- (5) Screen: Size 2, Length 15'
- (6) Were any formations sealed against pollution?  
\_\_\_\_\_ yes, \_\_\_\_\_ no.

If YES depth of formation \_\_\_\_\_

Why \_\_\_\_\_

Drillers Remarks: \_\_\_\_\_

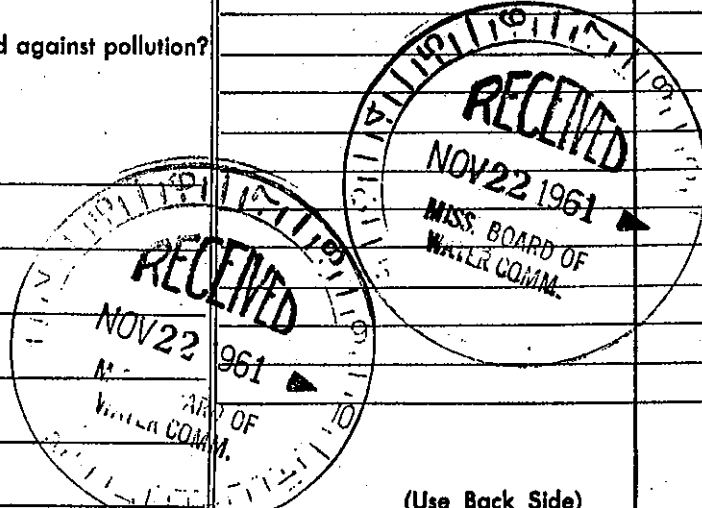

(Use Back Side)

Well No.

Mail this copy to Board of Water Commissioners 429 Miss. St. Jackson, Mis