

ATTALA MISSISSIPPI BOARD OF WATER COMMISSIONERS

Q 2004

9-24-62

WATER WELL DRILLERS LOG

Date: 9-24, 1962, Driller: Hearon County Leake
(Name)

(1) Owner of Land: <u>J. J. Merchant</u> <small>(Name)</small>	Description & Color of Materials Sand, Clay, Red Clay, Shell, etc.	Thick- ness Feet	Depth Feet
<u>Rt. 3, Kaskaskia, Miss.</u> <small>(Address)</small>	<u>Red clay</u> <u>yellow clay</u>	<u>6</u> <u>1384</u>	<u>6</u> <u>21 45</u>
(2) Location: <u>1/4</u> , <u>1/4</u> , Sec <u>31</u> <u>T39N</u> <u>5</u> miles <u>NNE</u> of <u>Thomastown</u> <small>(distance) (direction) (Nearest Town)</small>	<u>concrete reliability band</u> <u>White / white sand</u>	<u>21</u> <u>51</u>	<u>45</u> <u>96</u>
(3) Topography: <u>Hilly</u> <small>(Hilly) (Flat) (Level)</small>			
(4) Purpose of Well: <u>Domestic</u> <small>(Domestic Irrigation Municipal, Industrial, Other)</small>			


Information upon completion of well:

- (1) Diameter 2 inches.
- (2) Total Depth 96 feet.
- (3) Water Level 46 feet below top of ground.
- (4) Cased to 90', Size 2"
- (5) Screen: Size 1 1/2", Length 4ft
- (6) Were any formations sealed against pollution?
 yes, no.

If YES depth of formation _____

Why _____

Drillers Remarks: _____

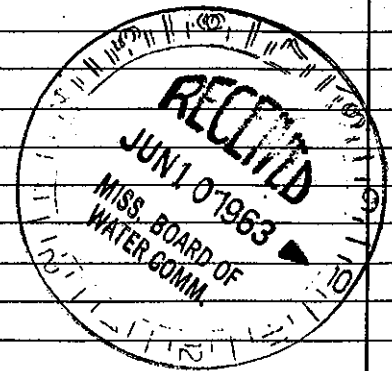

(Use Back Side)

Well No.