

ATTALA
 R 2005
 3-68

MISSISSIPPI
 BOARD OF WATER COMMISSIONERS
 416 North State Street
 Jackson, Mississippi 39201

WATER WELL DRILLERS LOG

3-7 1968 Thomas & Son A H A I A
 date well completed firm name ~320' county well located


LANDOWNER: Felix Hutchison
 Sallis Miss.
 SESE ~320'
 (mailing address)

WELL LOCATION:
 sec. 27 T 13 N R 5 E
 S W
 5 miles S of Sallis
 (distance) (direction) (nearest town)

WELL PURPOSE:
 (home irrigation, municipal, industrial)

- WELL COMPLETION DATA:
- (1) diameter (inches) 2
 - (2) total depth (feet) 506
 - (3) static water level (feet) 68 ^{below} _{above} top of ground.
 - (4) casing Galv. 420.
 (material) (depth)
 2" (size) If telescope see back.
 - (5) screen NONE
 (length) (depth to top)
 (size) open (material)
 - (6) pump 3/4 8
 (HP) (yield gpm)
 Elec (type power)
 - (7) electric log No
 (yes or no)
 (organization running log)
 - (8) how well bottom plugged

Description of formations encountered	from	to
Pipe Clay	0	21
Chalky Sand	21	50
Sand Rock	50	53
Hard Gray Chalk	53	62
Mostly Chalk	62	85
Little Fine Sand		
Fine Sand	85	160
Course Sand	160	226
Real Course Sand	226	270
Back to 60 G. Sand	270	300
Black Dirt	300	395
Rock Strs	395	395
Black Dirt	395	417
Rock & Shell	417	440
Green Sand	440	506

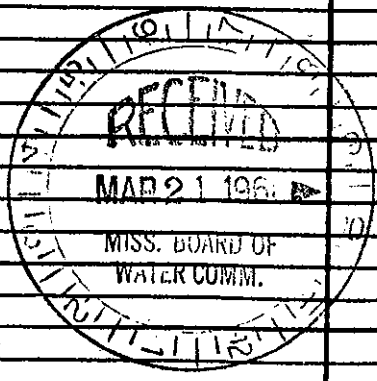

DRILLERS REMARKS: