

Attala  
Q 2007  
8-6-68

MISSISSIPPI  
 BOARD OF WATER COMMISSIONERS  
 416 North State Street  
 Jackson, Mississippi 39201

WATER WELL DRILLERS LOG

8-6 1968 Thomas Son Attala  
 date well completed ~ 320' firm name county well located

LANDOWNER: O. O. Edwards  
New Port, Miss.

Sallis, Miss.  
 (mailing address)


WELL LOCATION:  
 sec. 35 T 13 N R. 5 E NW  
IN New Port W SW  
 (distance) miles (direction) (nearest town)

WELL PURPOSE:  
 (Home, irrigation, municipal, industrial)

WELL COMPLETION DATA:

- (1) diameter (inches) 2
- (2) total depth (feet) 465
- (3) static water level (feet) 20 <sup>(below)</sup> <sub>(above)</sub> top of ground.
- (4) casing Galv. 352  
 (material) (depth)  
2"  
 (size) if telescope see back.
- (5) screen Open  
 (length) (depth to top)  
 (size) (material)
- (6) pump 1/2 5  
 (HP) (yield gpm)  
Elec.  
 (type power)
- (7) electric log NO  
 (yes or no)  
 (organization running log)
- (8) how well bottom plugged

description of formations encountered	from	to
Red Sandy Dirt	0	20
CHALKY SAND	20	60
SAND	60	96
Grey Chalk	96	108
STR. CHALK & SAND	108	126
Coarse SAND	126	245
Grey Chalk	245	250
Red Coarse SAND	250	285
BLACK DIRT	285	350
Rock & Shell	350	390
Mostly Shell	390	408
w/ little Green SAND streaks		
Solid Rock	408	410
Green SAND	410	465
w/ little Shell STR.		

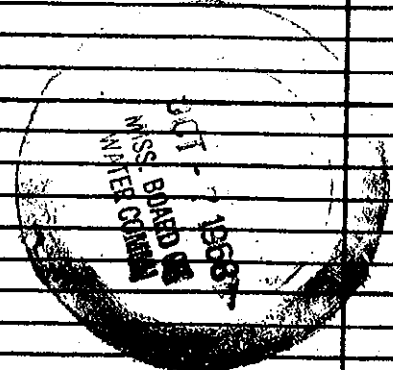

DRILLERS REMARKS: