

ATTALA MISSISSIPPI BOARD OF WATER COMMISSIONERS

Q <sup>2016</sup> ~~2009~~  
4-18-61

WATER WELL DRILLERS LOG


Q-301

Date: 4/18, 1961, Driller: James McGee County Attala  
(Name)

	Description & Color of Materials Sand, Clay, Red Clay, Shell, etc.	Thick- ness Feet	Depth Feet
(1) Owner of Land: <u>Charles Hudson.</u> (Name)	<u>Red clay.</u>	0	12
<u>Sallis, Miss.</u> (Address)	<u>Red sand.</u>	12	22
(2) Location: <u>1/4</u> , <u>1/4</u> , Sec. <u>T3R5E</u> <sup>(?)</sup> <u>26 or 27</u>	<u>Clay &amp; sand.</u>	22	52
<u>5</u> miles <u>South</u> , of <u>Sallis</u> (distance) (direction) (Nearest Town)	<u>Fine sand.</u>	52	62
(3) Topography: <u>X</u> (Hilly) (Flat) (Level)	<u>" " &amp; clay.</u>	62	82
(4) Purpose of Well: <u>Domestic.</u> (Domestic Irrigation Municipal, Industrial, Other)	<u>Fine sand.</u>	82	162
	<u>Sand. Not good water.</u>	162	262
	<u>Clay.</u>	262	358
	<u>Clay &amp; stks. rock.</u>	358	362
	<u>Shale.</u>	362	372
	<u>Shale &amp; stks. rock.</u>	372	402
	<u>Clay &amp; stks. sand.</u>	402	422
	<u>Fine sand.</u>	422	452
	<u>Sand. (Screen set.)</u>	452	467

Information upon completion of well:

- (1) Diameter 2 inches.
- (2) Total Depth 467 feet.
- (3) Water Level 35 feet below top of ground.
- (4) Cased to 457', Size 2"
- (5) Screen: Size 2", Length 10'
- (6) Were any formations sealed against pollution?  
no.
- If YES depth of formation \_\_\_\_\_
- Why \_\_\_\_\_
- Drillers Remarks: Good well.

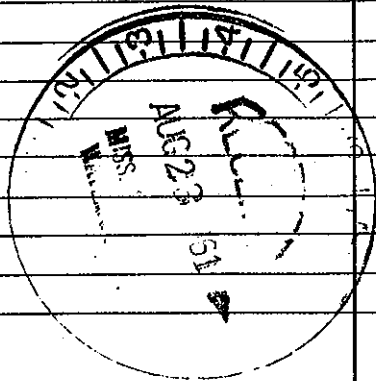

(Use Back Side)

Well No.

Mail this copy to Board of Water Commissioners 429 Miss. St. Jackson, Miss.