

ATTALA MISSISSIPPI BOARD OF WATER COMMISSIONERS

R 34
3-65

WATER WELL DRILLERS LOG

CODED

Date: March, 1965, Driller: Thomas & Son County ATTALA
(Name)

(1) Owner of Land: SAM PAYNE
(Name)
MEADAMS, MISS.
(Address)

(2) Location: 1/4, 1/4, Sec. 4 T13R6
1/2 miles South of MEADAMS
(distance) (direction) (Nearest Town)

(3) Topography: (Hilly) (Flat) (Level)

(4) Purpose of Well: (Domestic) Irrigation
Municipal, Industrial, Other

Description & Color of Materials Sand, Clay, Red Clay, Shell, etc.	Thick- ness Feet	Depth Feet
<u>Dirt</u>	<u>20</u>	<u>0</u>
<u>White Sand</u>	<u>5</u>	<u>20</u>
<u>Black Dirt</u>	<u>90</u>	<u>25</u>
<u>Rock & Shell</u>	<u>40</u>	<u>115</u>
<u>Grey Sand w/shell</u>	<u>37</u>	<u>150</u>

Information upon completion of well:

(1) Diameter 2 inches.

(2) Total Depth 192 feet.

(3) Water Level Flows feet below top of ground.

(4) Cased to 126, Size 2"

(5) Screen: Size _____, Length _____


(6) Were any formations sealed against pollution?
_____ yes, ✓ no.

If YES depth of formation _____

Why _____

Drillers Remarks: _____

CODED

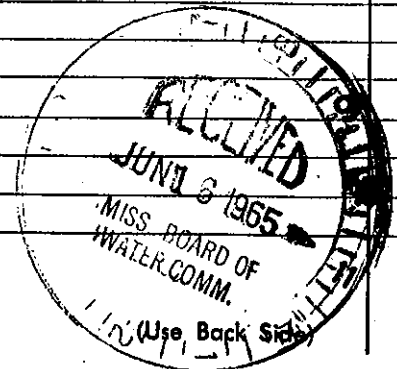

Well No.