

Attala
R-45
2000

MISSISSIPPI DEPARTMENT OF NATURAL RESOURCES
Bureau of Land and Water Resources
Southport Mall
P.O. Box 10631
Jackson, Mississippi 39209
WATER WELL DRILLERS LOG

2-28 2000 GRINER DRUG SERVICE Attala
date well completed firm name county well located

LANDOWNER: DUKE ENERGY
PG&E owner/operator at Plant
(mailing address)

description of formations encountered	from	to
See attached		
Elev. 322'		
Clay	0	15
Sand	15	55
Clay rocks 91, 124, 132	55	140
Sand	140	159
Clay w/ sand shks	159	190
Sand	190	218
Clay w/ rocks	218	221
Sand	221	253

WELL LOCATION:
SW 1/4 NE 1/4 Sec. 3 T. 13 N R. 6 E
1 1/2 miles east of ME Adams
(distance) (direction) (nearest town)


WELL PURPOSE: Test
(home, irrigation, municipal, industrial)

- WELL COMPLETION DATA:
- (1) diameter (inches) 6
 - (2) total depth (feet) 250
 - (3) static water level (feet) +14.7 below top of ground. (above)
 - (4) casing Steel 190' (material) (depth)
 - (5) screen 60' 190' (length) (depth to top)
 - 6" SS (size) (material)
 - (6) pump None (HP) (yield gpm)
 - None (type power)
 - (7) electric log Yes T.H.#1 (yes or no)
 - SCHLUMBERGER (organization running log)
 - (8) how well bottom plugged

TALLAHATA
BBS WELL

DRILLERS REMARKS: casing cemented to surface

DUKE ENERGY - ATTALA COUNTY, MISSISSIPPI
OBSERVATION WELL COMPLETED
IN THE TALLAHATTA FORMATION.

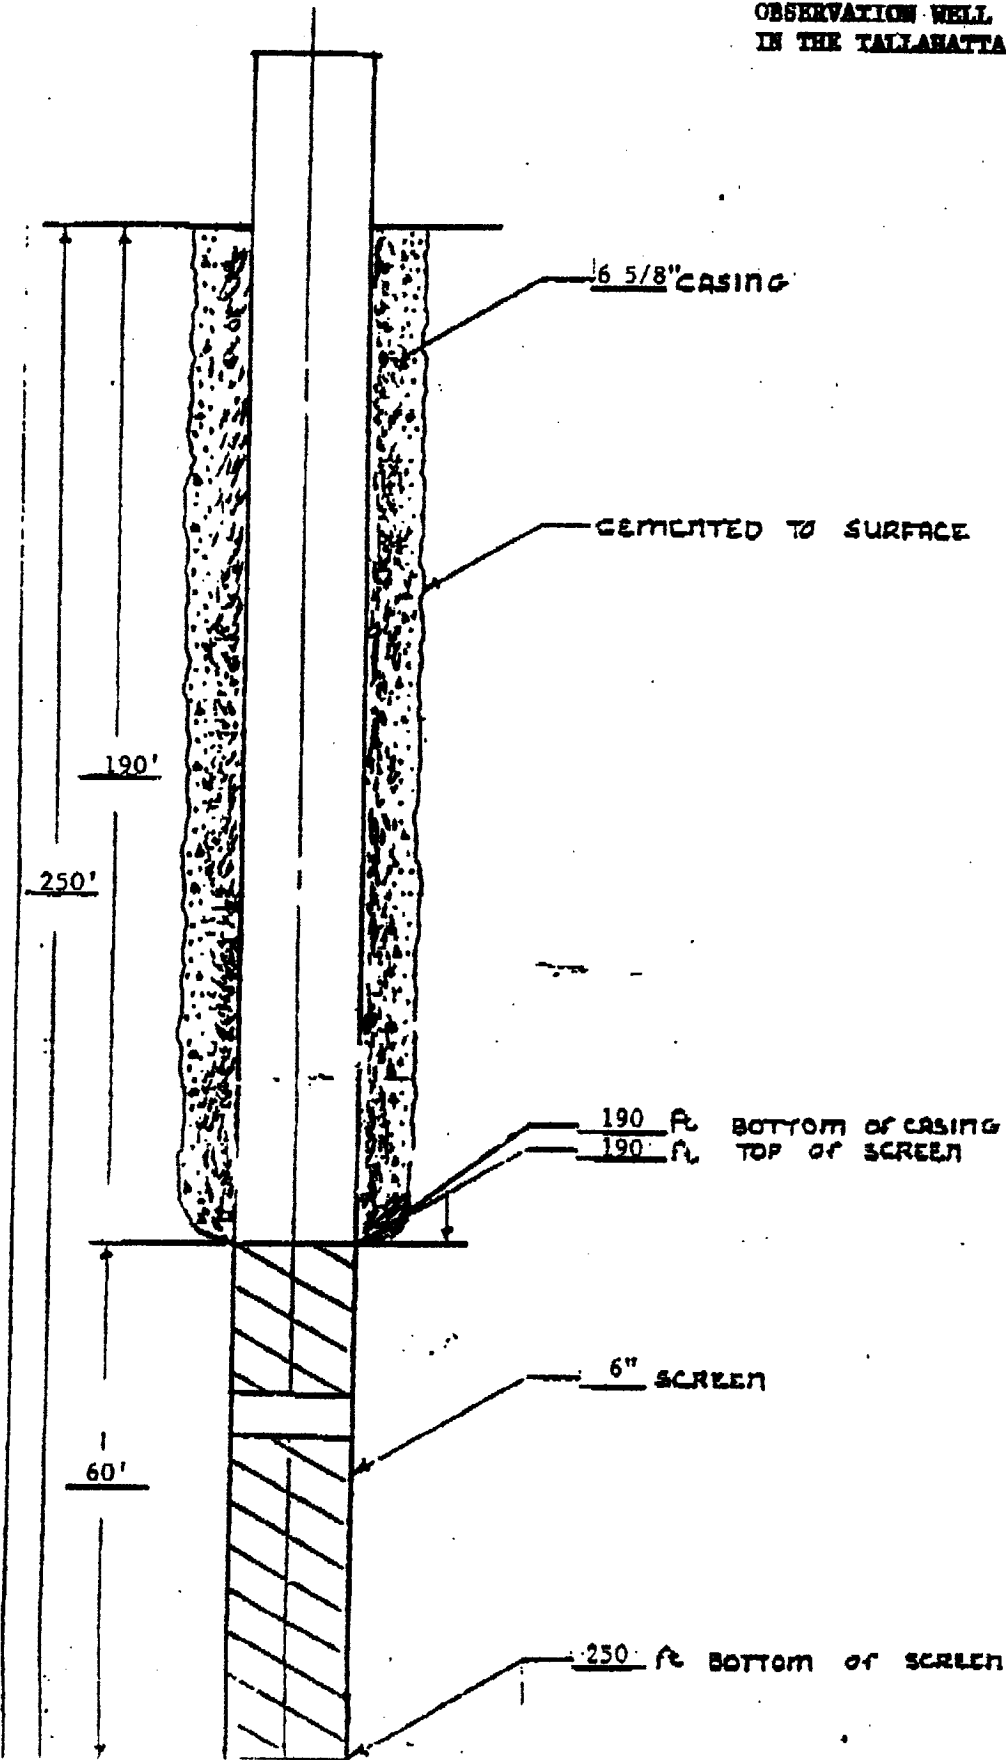

GRINER DRILLING SERVICE, INC.

TELEPHONE 601/736-6347

P. O. DRAWER 825

COLUMBIA, MS 39429

PAGE 1 OF 1

FORMATION LOG FOR DUKE ENERGY - ATTALA COUNTY

TEST HOLE NO. <u>2</u>	ADDRESS _____
	TEST HOLE LOCATION <u>PLANT SITE</u>

FORMATION AND TEST HOLE INFORMATION

TOTAL DEPTH	THICKNESS EACH STRATUM	FORMATION	REMARKS
15	15	CLAY	
55	40	SAND	
140	85	CLAY (ROCKS AT 91, 124, 132)	
159	19	SAND	
190	31	SAND WITH CLAY STREAKS	
218	28	SAND	
227	9	CLAY WITH ROCKS	
253	26	SAND	

Date Started _____ Date Completed _____

Field Engineer
Driiler