

ATTALA MISSISSIPPI BOARD OF WATER COMMISSIONERS


R 2001

WATER WELL DRILLERS LOG

1-22-63

Date: 1-22, 1963, Driller: Thomas & Son County Attala
(Name)

	Description & Color of Materials Sand, Clay, Red Clay, Shell, etc.	Thick- ness Feet	Depth Feet
(1) Owner of Land: Mrs. beta B. Brown Floyd Brown (Name) Kosciusko, Miss. (Address)	Red clay	15	0-15
(2) Location: S 1/4, SE 1/4, Sec. 13 T13R6, 1 1/2 miles S-W of Kosciusko (distance) (direction) (Nearest Town)	Dry sand little clay	75	15-90
(3) Topography: Hilly (Hilly) (Flat) (Level)	SAND - Fine to coarse	86	95-126
(4) Purpose of Well: Domestic (Domestic Irrigation Municipal, Industrial, Other)			
Information upon completion of well:			
(1) Diameter 2 inches.			
(2) Total Depth 126 feet.			
(3) Water Level 85 feet below top of ground.			
(4) Cased to 120, Size 2			
(5) Screen: Size 60B, Length 6ft.			
(6) Were any formations sealed against pollution?			
_____ yes, <input checked="" type="checkbox"/> no.			
If YES depth of formation _____			
Why _____			
Drillers Remarks: _____			

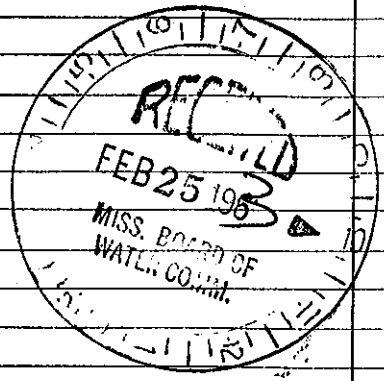

(Use Back Side)

Well No.

Mail this copy to Board of Water Commissioners 429 Miss. St. Jackson, Miss