


Attala
R203
8-66

MISSISSIPPI BOARD OF WATER COMMISSIONERS

WATER WELL DRILLERS LOG

Date: Aug, 1966, Driller: Jack Martin County Attala
(When well drilled) (Name) (Where well is located)

(1) Owner of Land: <u>J.P. Lova</u> (Name)	Description & Color of Materials Sand, Clay, Red Clay, Shell, etc.	Thick- ness Feet	Depth Feet
<u>Schula - Route</u> (Address)	Clay	14	14
	Sand	101	115
	Mud	45	160
(2) Location: <u>SW 1/4, SW 1/4, Sec. 12, T4 R6</u>	Mud - rock layers	5	165
<u>2</u> miles <u>SE</u> , of <u>McAdams</u> (distance) (direction) (Nearest Town)	Mud	21	186
	Mud - rock layers	6	191
(3) Topography: <u>Hilly</u> (Hilly) (Flat) (Level)	Green sand - shale	17	208
(4) Purpose of Well: <u>Domestic</u> (Domestic Irrigation Municipal, Industrial, Other)	Rock	2	210
	Shale - Sand	25	235
	Sand	12	247
	Sand - shale	18	265
	Sand	13	278
	Hard rock	1	279
(1) Diameter <u>4 1/2</u> inches.	Mud	12	291
(2) Total Depth <u>680</u> feet.	Rock	2	293
(3) Water Level <u>52</u> feet below top of ground.	Sand	9	302
(4) Cased to <u>63.5</u> , Size <u>4" x 2"</u>	Rocks - mud layers	19	321
(5) Screen: Size <u>2"</u> , Length <u>15'</u>	Rock	1	322
(6) Were any formations sealed against pollution? _____ yes, <u>✓</u> no.	Mud - rock layers	63	385
If YES depth of formation _____	Sand	8	393
Why _____	Mud - rock layers	17	410
Drillers Remarks: <u>Good water (no iron - hardness = 300 grains per gal)</u>	Sand + Mud	20	438
Yield in gpm: <u>25</u>	Sand	24	462
Size pump: <u>1 H.P.</u>	Mud - few sand streaks	68	630
Type power: <u>Electric</u>	Sand	50	680

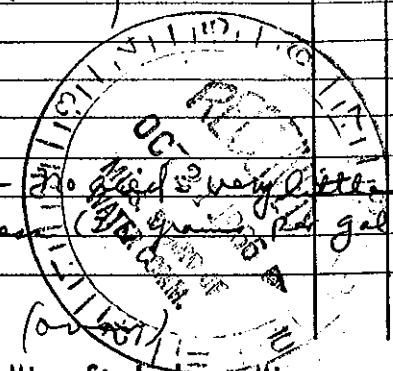

Mail this copy to Board of Water Commissioners 429 Miss. St. Jackson, Miss.